


Claim of Beneficial Use - Red Hills Farm, LLC

Application R-88695, Permit R-15491

Township 3S, Range 2W, W.M.

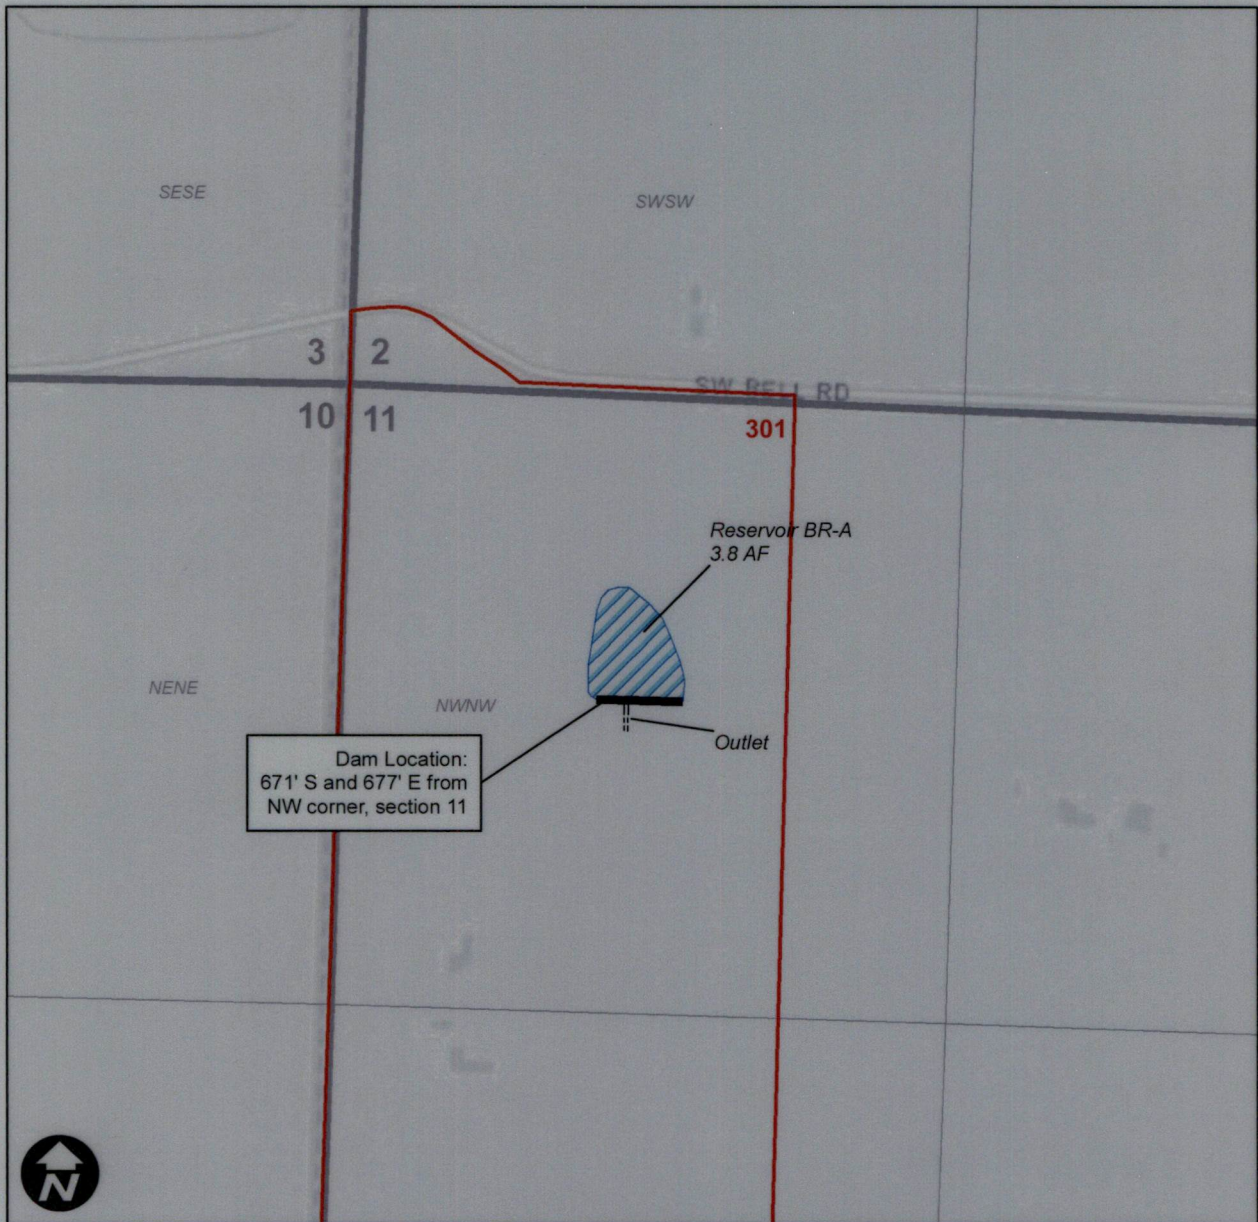

0 200 400 800 Feet

This map is not intended to provide legal dimensions or locations of property ownership lines.

Legend

 Reservoir  Taxlot



EXPIRES: 12-31-2026 received by OWRD