


Claim of Beneficial Use - Saetern

Application G-16924, Permit G-16481

Township 12S, Range 3W, W.M.

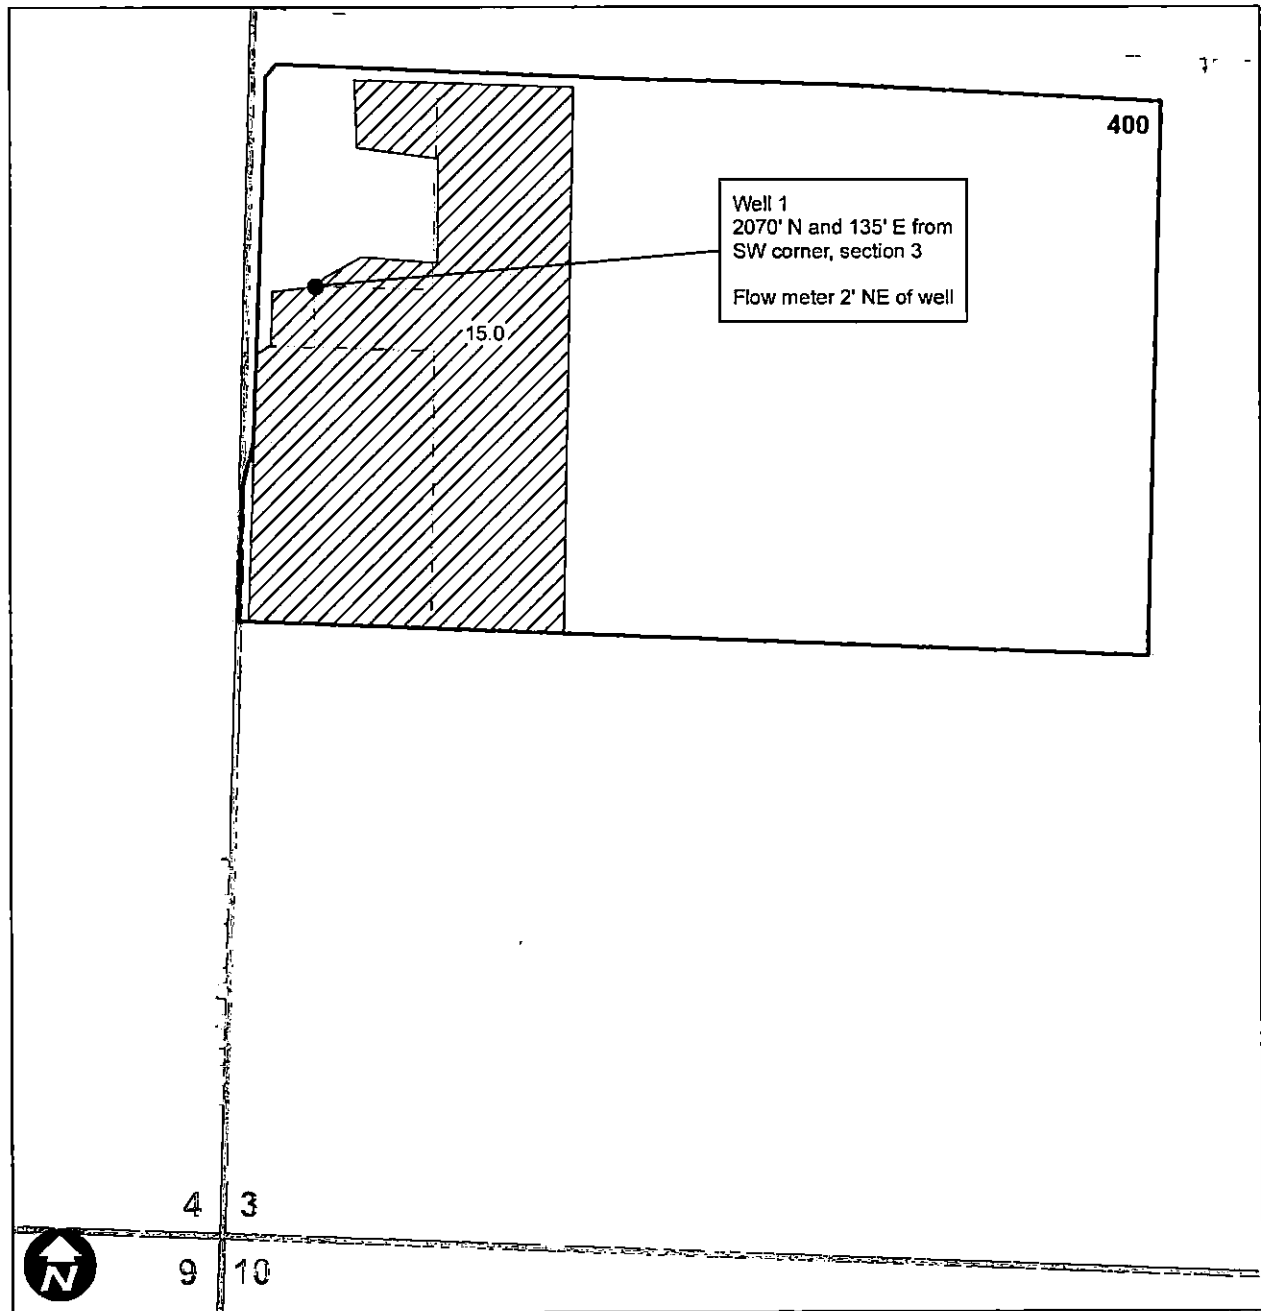

0 200 400 800 Feet

This map is not intended to provide legal dimensions or locations of property ownership lines.

Legend

IR POU - - Mainline Taxlot



RECEIVED BY OWNER

FEB 24 2020

SAETERN, OR

EXPIRES: