


# T.7S. R.2W. Sec. 28, 29, 32, & 33, W.M.

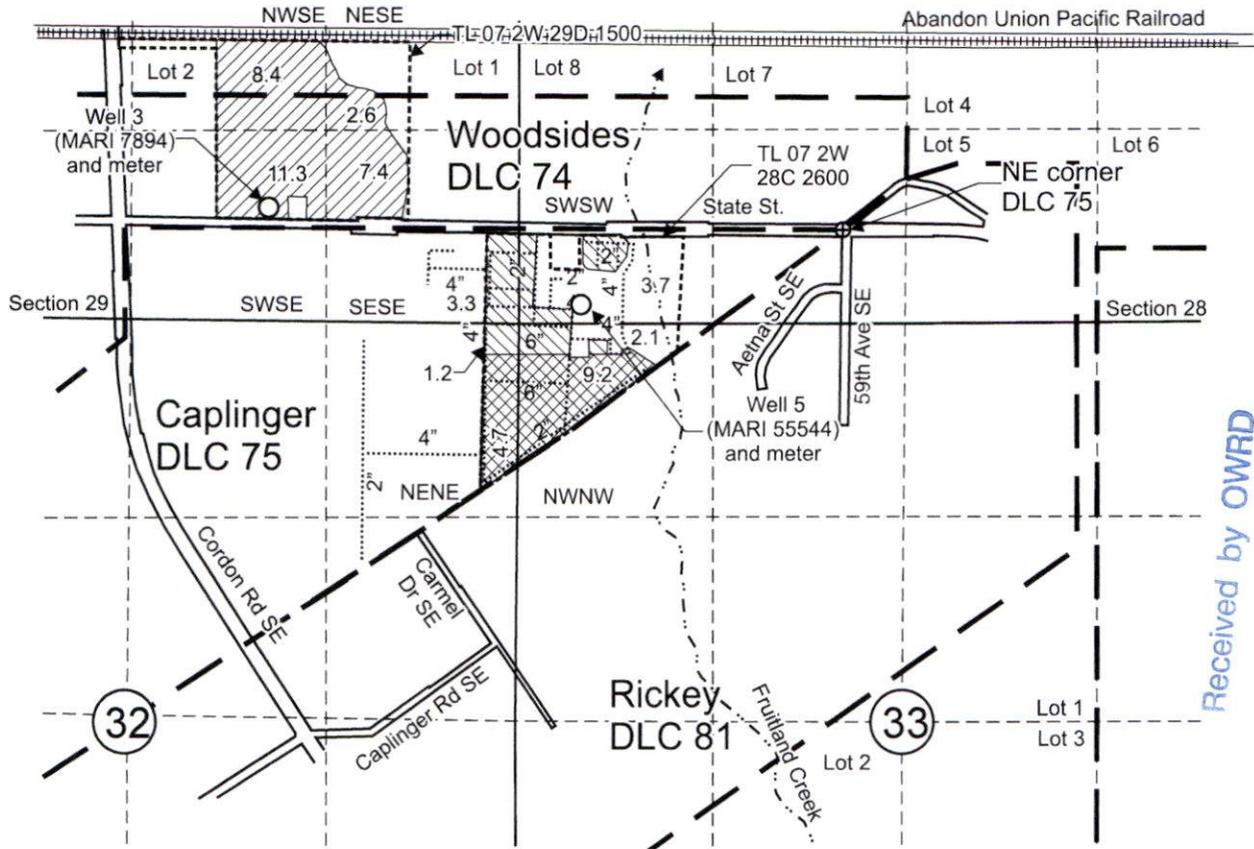

Received by OWRD  
 FEB 25 2026  
 Salem, OR

Well 3 (MARI 7894) is located 800 feet north and 1,700 feet west from the SE corner, Section 29.


Well 5 (MARI 55544) is located 130 feet north and 425 feet east from the SW corner, Section 28.

- Area (29.7 Acres) irrigated under Application G-12222, Permit G-18909, T-14418, priority date: 9-5-1990, using Well 3 per claim of beneficial use submitted 10-26-1993.
- Area (10.3 Acres) irrigated under Application G-12222, Permit G-18909, T-14418, priority date: 10-26-1993.
- Area (13.9 Acres) irrigated under Application G-12222, Permit G-18909, T-14418, priority date: 9-5-1990.

- Tax lot boundary
- . — Donation Land Claim boundary
- ..... Water main line



This map was prepared for the purpose of identifying the location of a water right only and is not intended to provide legal dimensions or location of property ownership lines.

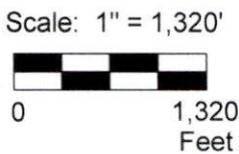

**Claim of Beneficial Use Map**  
**Application G-12222, Permit G-18909, T-14418**

JLPN Inc., c/o John Lewis  
 T.7S. R.2W. Sec. 28, 29, 32, & 33, W.M.

03/2026