



POD Location:

600' S, 1740' W of NE Cor Sec 3



RENEWS: 06/30/2026

T28S R13E & T29S R13E WM, LAKE COUNTY, OR

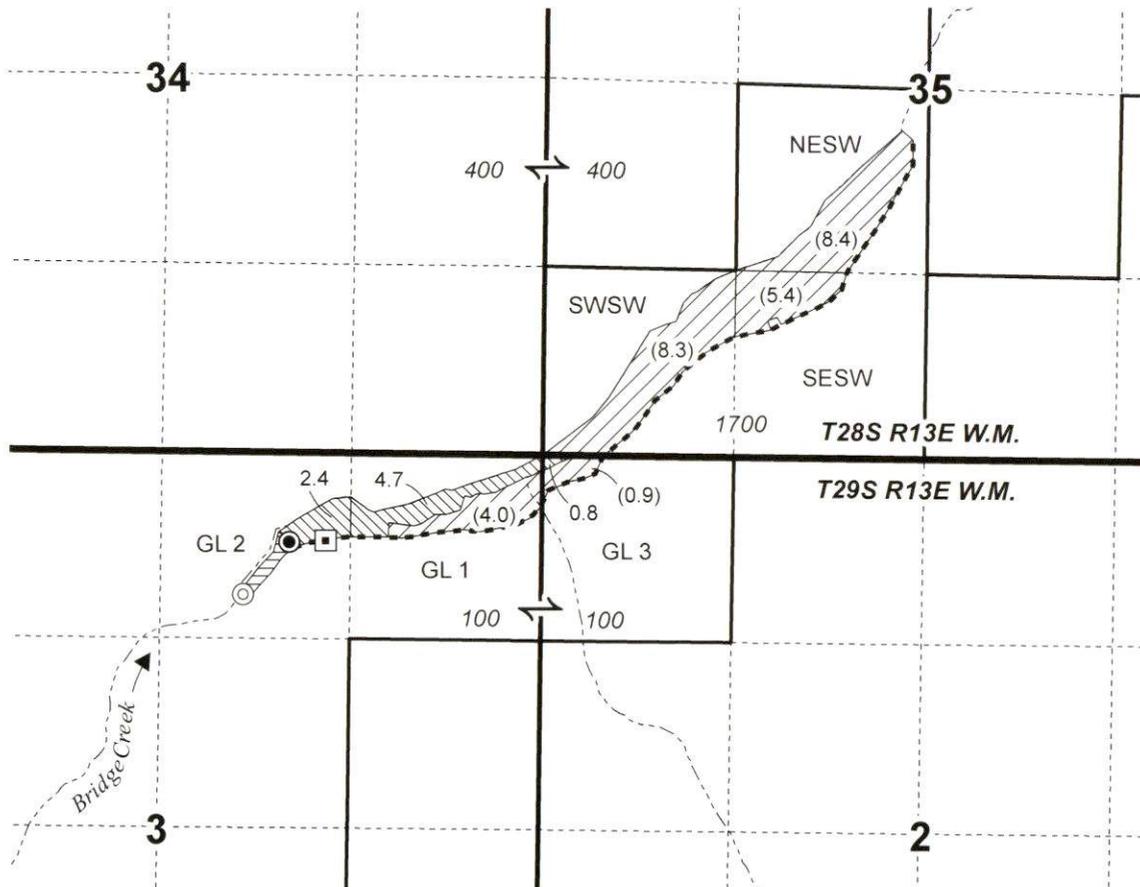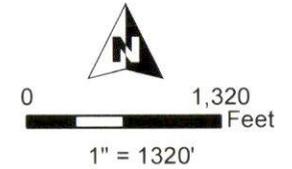

- POD
- Weir
- ⊙ Fish Screen & Staff Gauge
- Creek
- - - - Ditch
- ▨ Reservoir (C-91939 Stored Water)
- ▧ POU IR
- ▩ POU (IS)
- ▭ Township
- ▭ Section
- Quarter Quarter
- ▭ Tax Lot

Received
FEB 26 2026
OWRD



CLAIM OF BENEFICIAL USE MAP BELL "A" LAND AND CATTLE COMPANY

This map is not intended to provide legal dimensions or locations of property ownership lines.

WATER RIGHT SERVICES, LLC
PO BOX 1830, BEND, OR 97709
WWW.OREGONWATER.US 541-389-2837
brycewrs@gmail.com

Date: 12/22/2025

Ap S-89288 Permit S-55426