
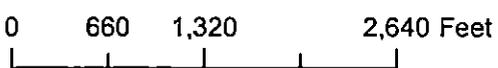


Claim of Beneficial Use - K.A. Berger Farms, Inc.

Application S-88895, Permit S-55301

Township 5S, Range 5W, W.M.

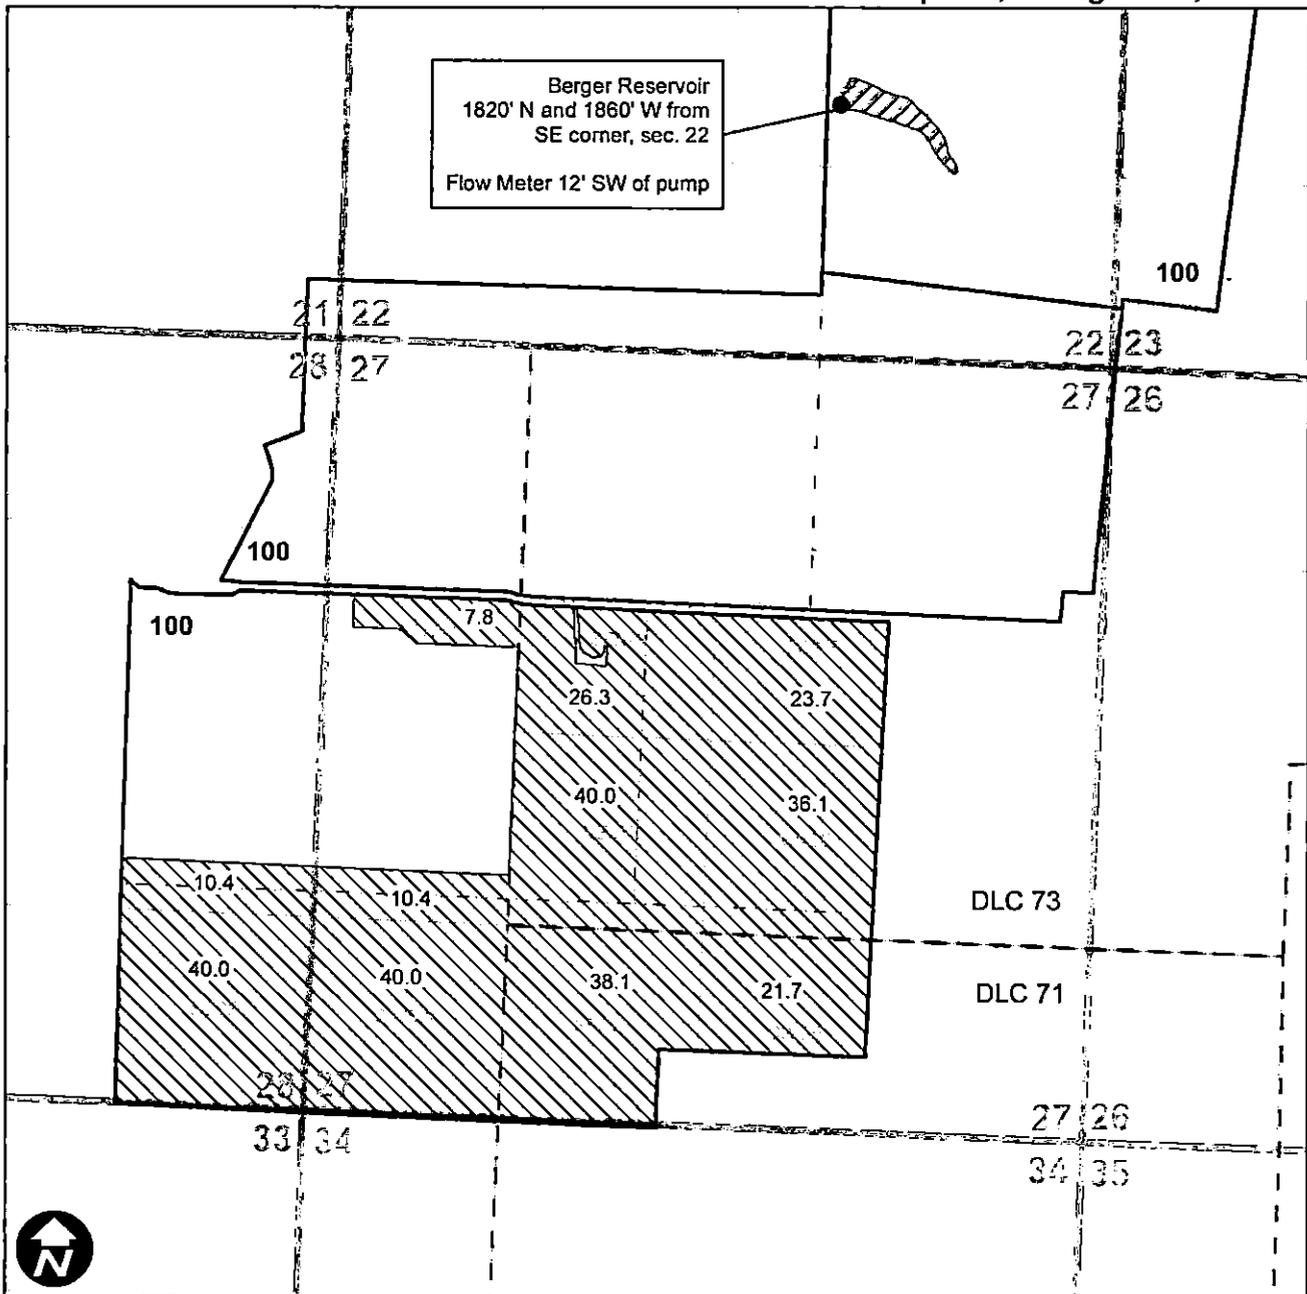

This map is not intended to provide legal dimensions or locations of property ownership lines.

Legend

- IR POU
- Berger Reservoir
- Taxlot
- Mainline
- DLC



Received by OWPD

FEB 26 2023

Section 05