


THIS MAP IS NOT INTENDED TO PROVIDE LEGAL DIMENSIONS OR LOCATIONS OF PROPERTY OWNERSHIP LINES.


Application# S-88315, Permit# S-55040

Township 15S, Range 5W, Section 13 of the Willamette Meridian

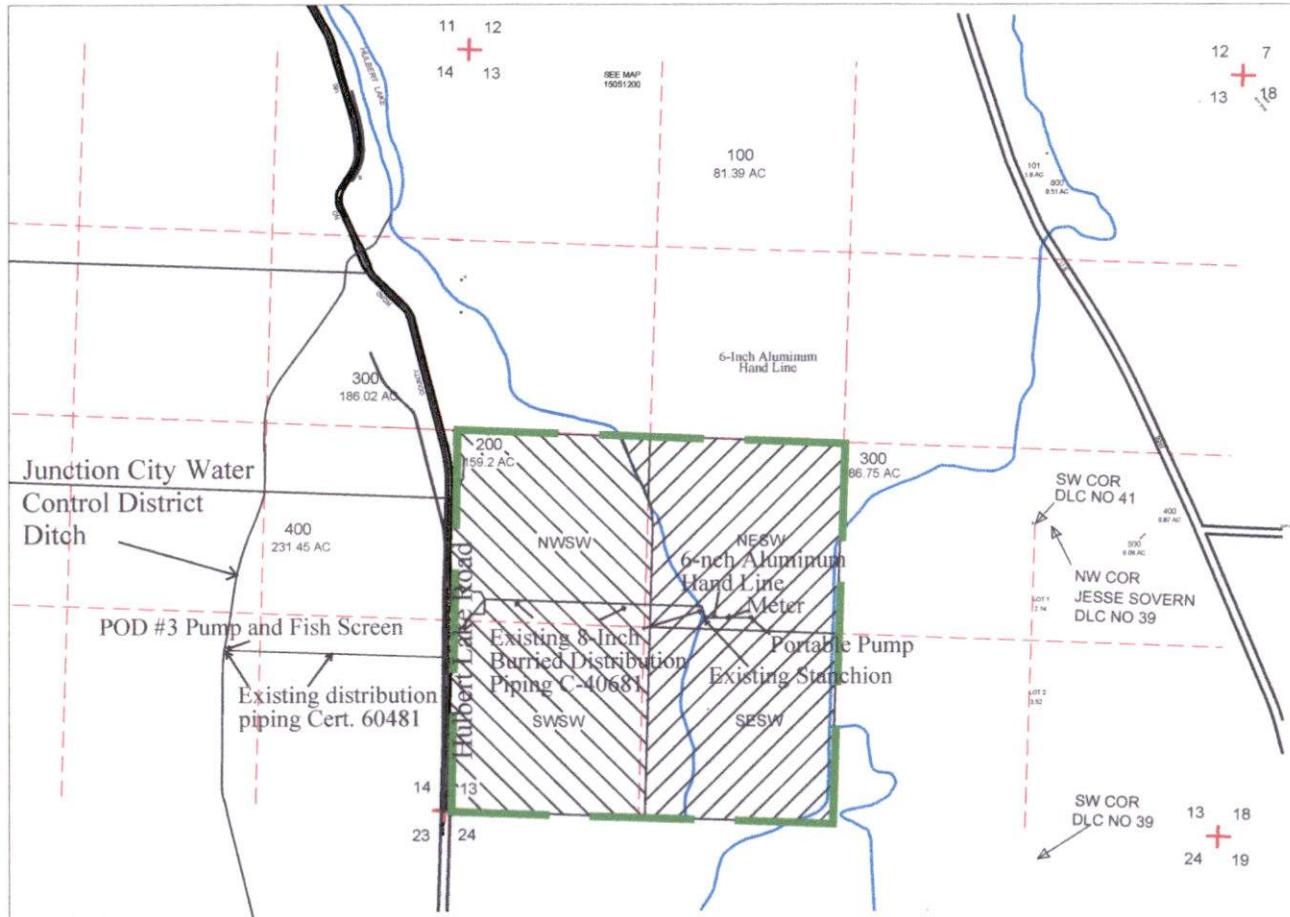


Lane County Tax Lot 15-05-13-00-00200

Twnshp	Rng	Sec	Qtr-Qtr	Qtr	Acres
15S	5W	13	NW	SW	1.07
15S	5W	13	NE	SW	39.62
15S	5W	13	SE	SW	38.82
					79.51

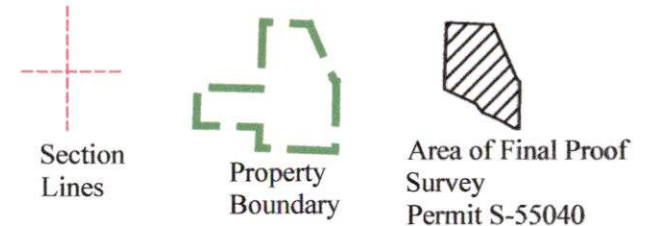

Received
MAR 02 2026
OWRD

Received
MAR 02 2026
OWRD
Section 23
NW 1/4 SW 1/4

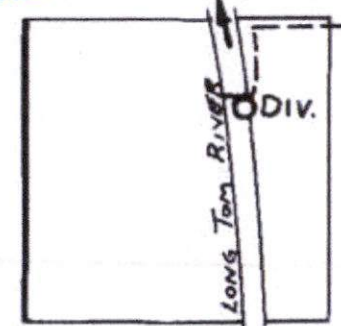

EXPIRATION DATE:12/31/26

POD #3 - Point of re-diversion.
Pump is 1500 feet west and
1120 feet north of the
SW corner of Section 13.

River diversion is approximately 2220 ft. N and
930 ft. E from SW corner of Section 23