


T.5S. R.1W. Sec. 29, 30, & 32, W.M.

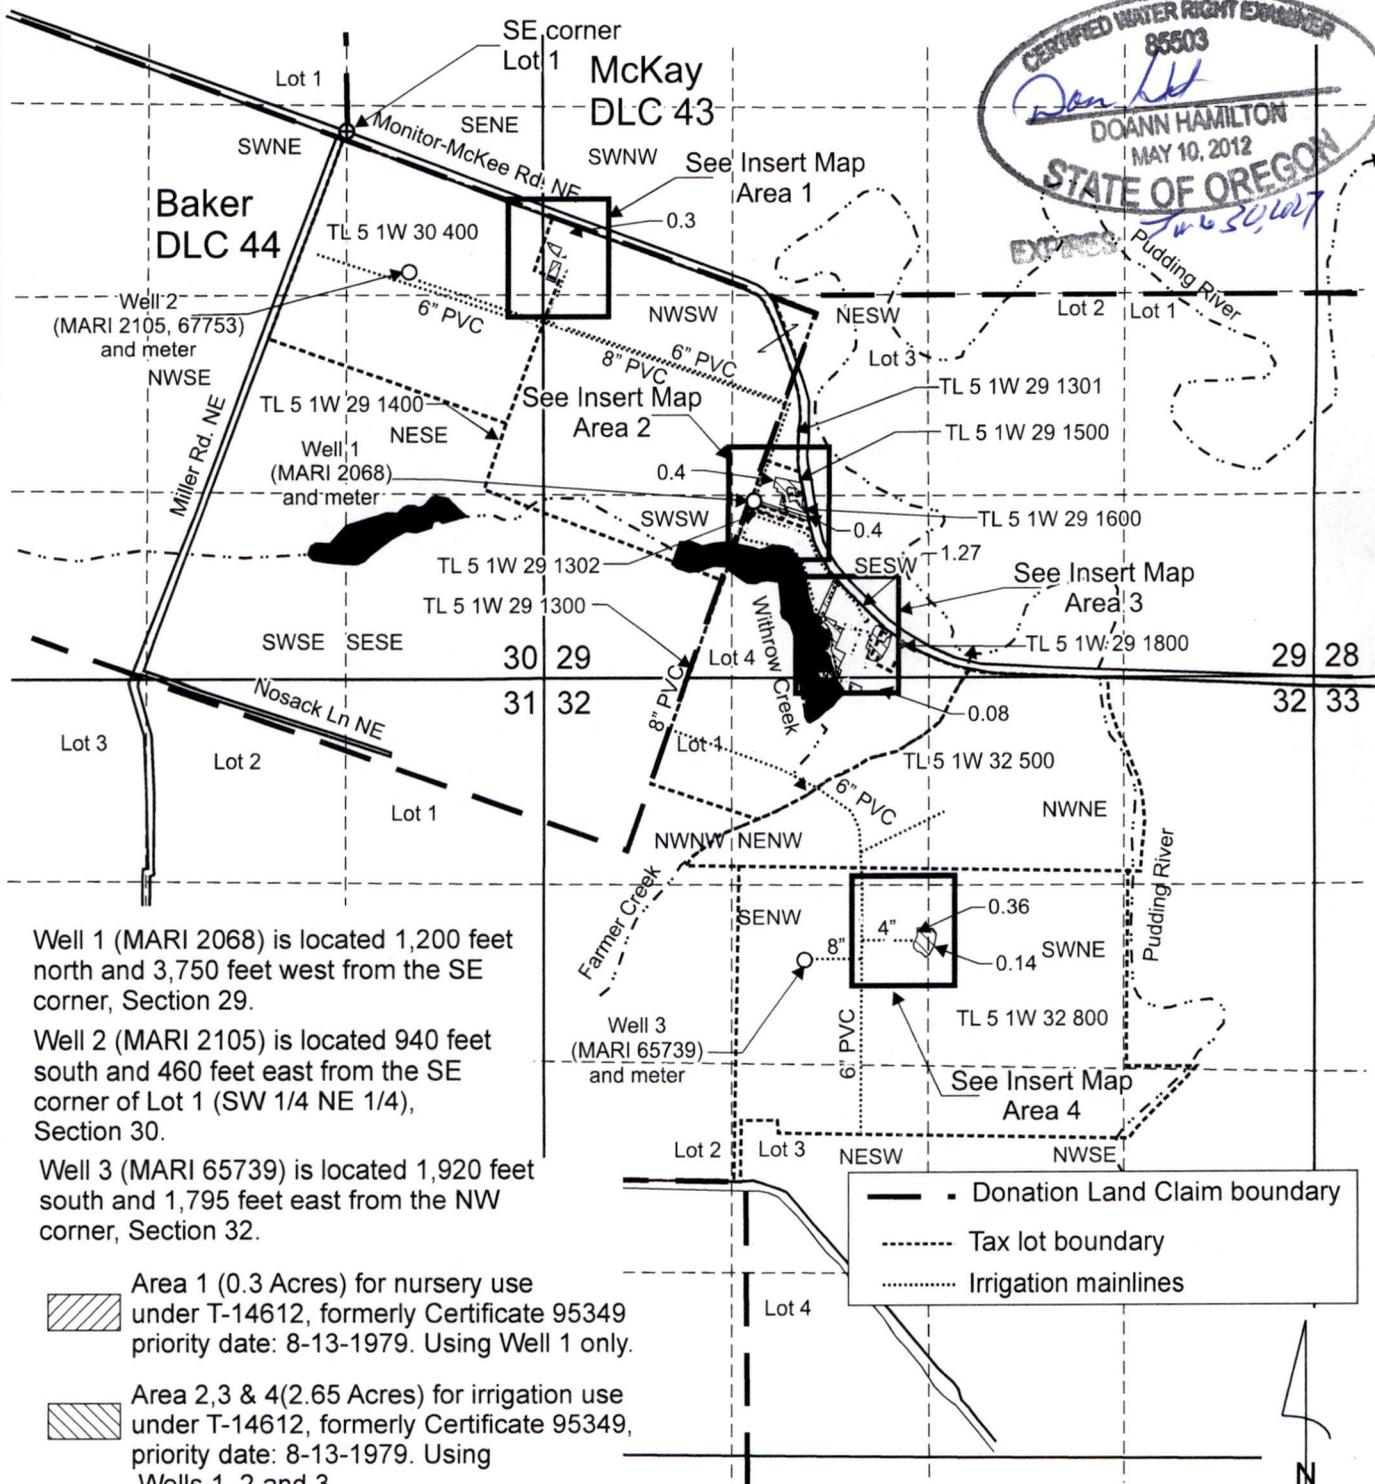

Well 1 (MARI 2068) is located 1,200 feet north and 3,750 feet west from the SE corner, Section 29.

Well 2 (MARI 2105) is located 940 feet south and 460 feet east from the SE corner of Lot 1 (SW 1/4 NE 1/4), Section 30.

Well 3 (MARI 65739) is located 1,920 feet south and 1,795 feet east from the NW corner, Section 32.

Area 1 (0.3 Acres) for nursery use under T-14612, formerly Certificate 95349 priority date: 8-13-1979. Using Well 1 only.

Area 2,3 & 4 (2.65 Acres) for irrigation use under T-14612, formerly Certificate 95349, priority date: 8-13-1979. Using Wells 1, 2 and 3.

Scale: 1" = 1,320'



This map was prepared for the purpose of identifying the location of a water right only and is not intended to provide legal dimensions or location of property ownership lines.

Claim of Beneficial Use Map
T-14612, formerly Certificate 95349

Received by OWRD

Treco Investments LLC.
T.5S. R.1W. Sec. 29, 30 and 32, W.M.

MAR 02 2026

WILL MCGILL SURVEYING LLC

02/2026

Salem, OR

Treco T-14612COBUMap.cdr

T.5S. R.1W. Section 29, W.M.


TL 5 1W 30 400

Baker
DLC 44

0.3

Monitor-McKee Rd. NE

TL 5 1W 29 1400

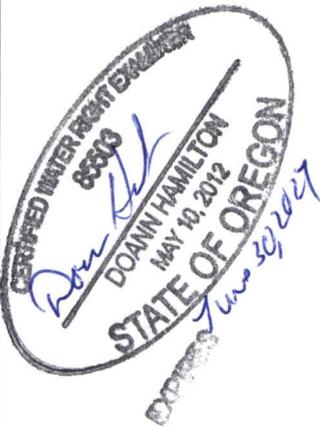

Well 1 (MARI 2068) is located 1,200 feet north and 3,750 feet west from the SE corner, Section 29.

Area 1 (0.3 Acres) for nursery use under T-14612, formerly Certificate 95349, priority date: 8-13-1979.

Section 30
Section 29

SENE
NESE

SWNW
NWSW

- Tax lot boundary
- . — Donation Land Claim boundary
- Irrigation mainlines

Received by OWRD


MAR 02 2026

Salem, OR

This map was prepared for the purpose of identifying the location of a water right only and is not intended to provide legal dimensions or location of property ownership lines.



Scale: 1" = 100'

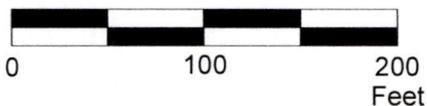

Trecot-14612COBUArea1Map.cdr

WILL MCGILL SURVEYING LLC



Claim of Beneficial Use Map: Area 1
T-14612, formerly Certificate 95349

Treco Investments LLC
T.5S. R.1W. Section 29, W.M.

02/2026

T.5S. R.1W. Section 29, W.M.

-  Donation Land Claim boundary
-  Tax lot boundary
-  Irrigation mainlines

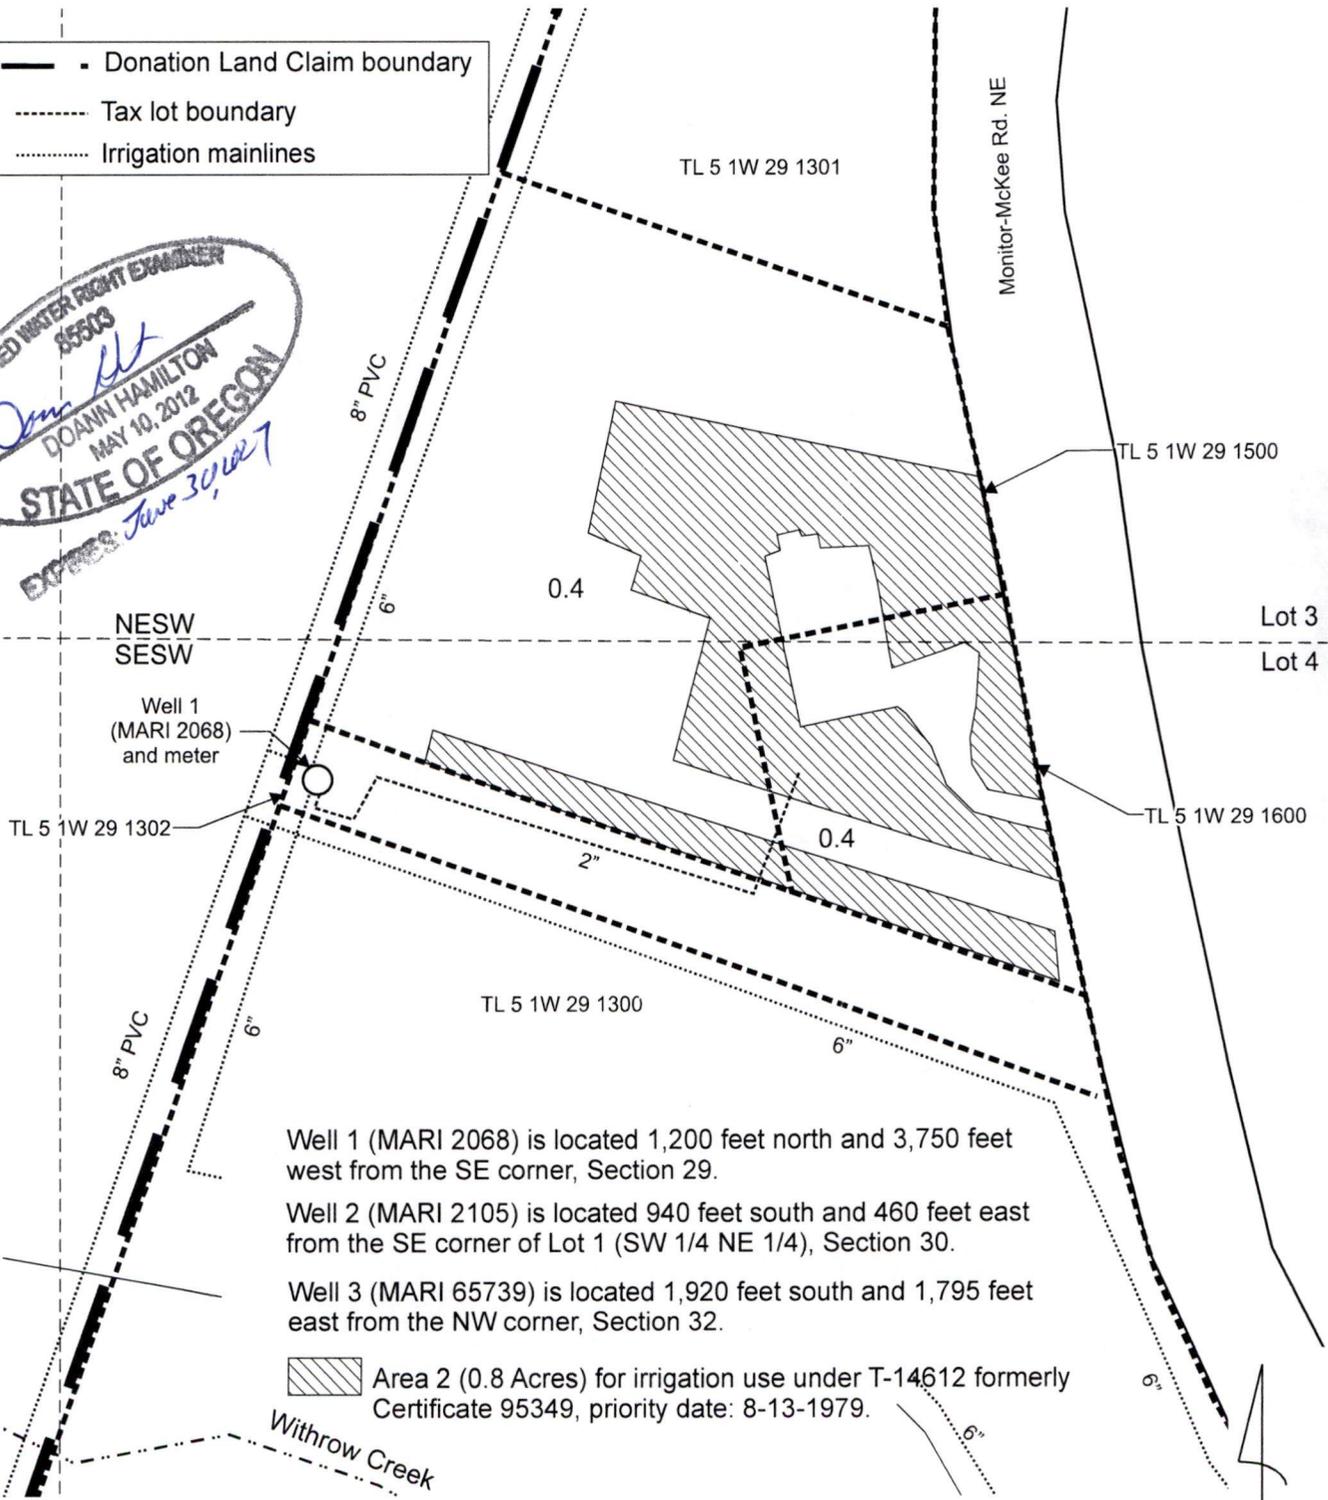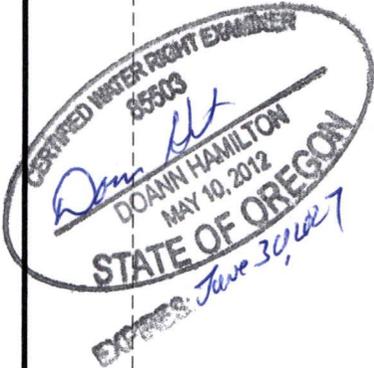


Well 1 (MARI 2068) is located 1,200 feet north and 3,750 feet west from the SE corner, Section 29.

Well 2 (MARI 2105) is located 940 feet south and 460 feet east from the SE corner of Lot 1 (SW 1/4 NE 1/4), Section 30.

Well 3 (MARI 65739) is located 1,920 feet south and 1,795 feet east from the NW corner, Section 32.

 Area 2 (0.8 Acres) for irrigation use under T-14612 formerly Certificate 95349, priority date: 8-13-1979.

Scale: 1" = 100'

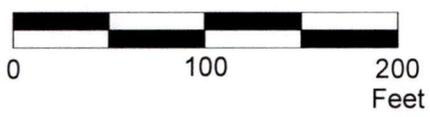

This map was prepared for the purpose of identifying the location of a water right only and is not intended to provide legal dimensions or location of property ownership lines.

Claim of Beneficial Use Map: Area 2
T-14612, formerly Certificate 95349

Treco Investments LLC
T.5S. R.1W. Section 29, W.M.

MAR 02 2026


 WILL MCGILL SURVEYING LLC

02/2026


Salem, OR

T:recoT-14612COBUArea2Map.cdr

T.5S. R.1W. Sec. 29 and 32, W.M.

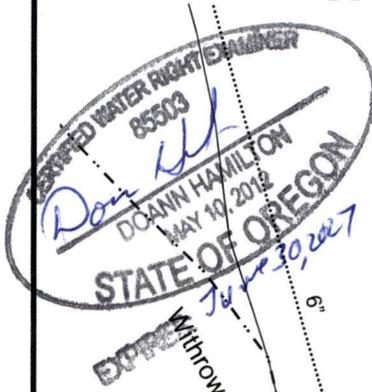

- Donation Land Claim boundary
- Tax lot boundary
- Irrigation mainlines

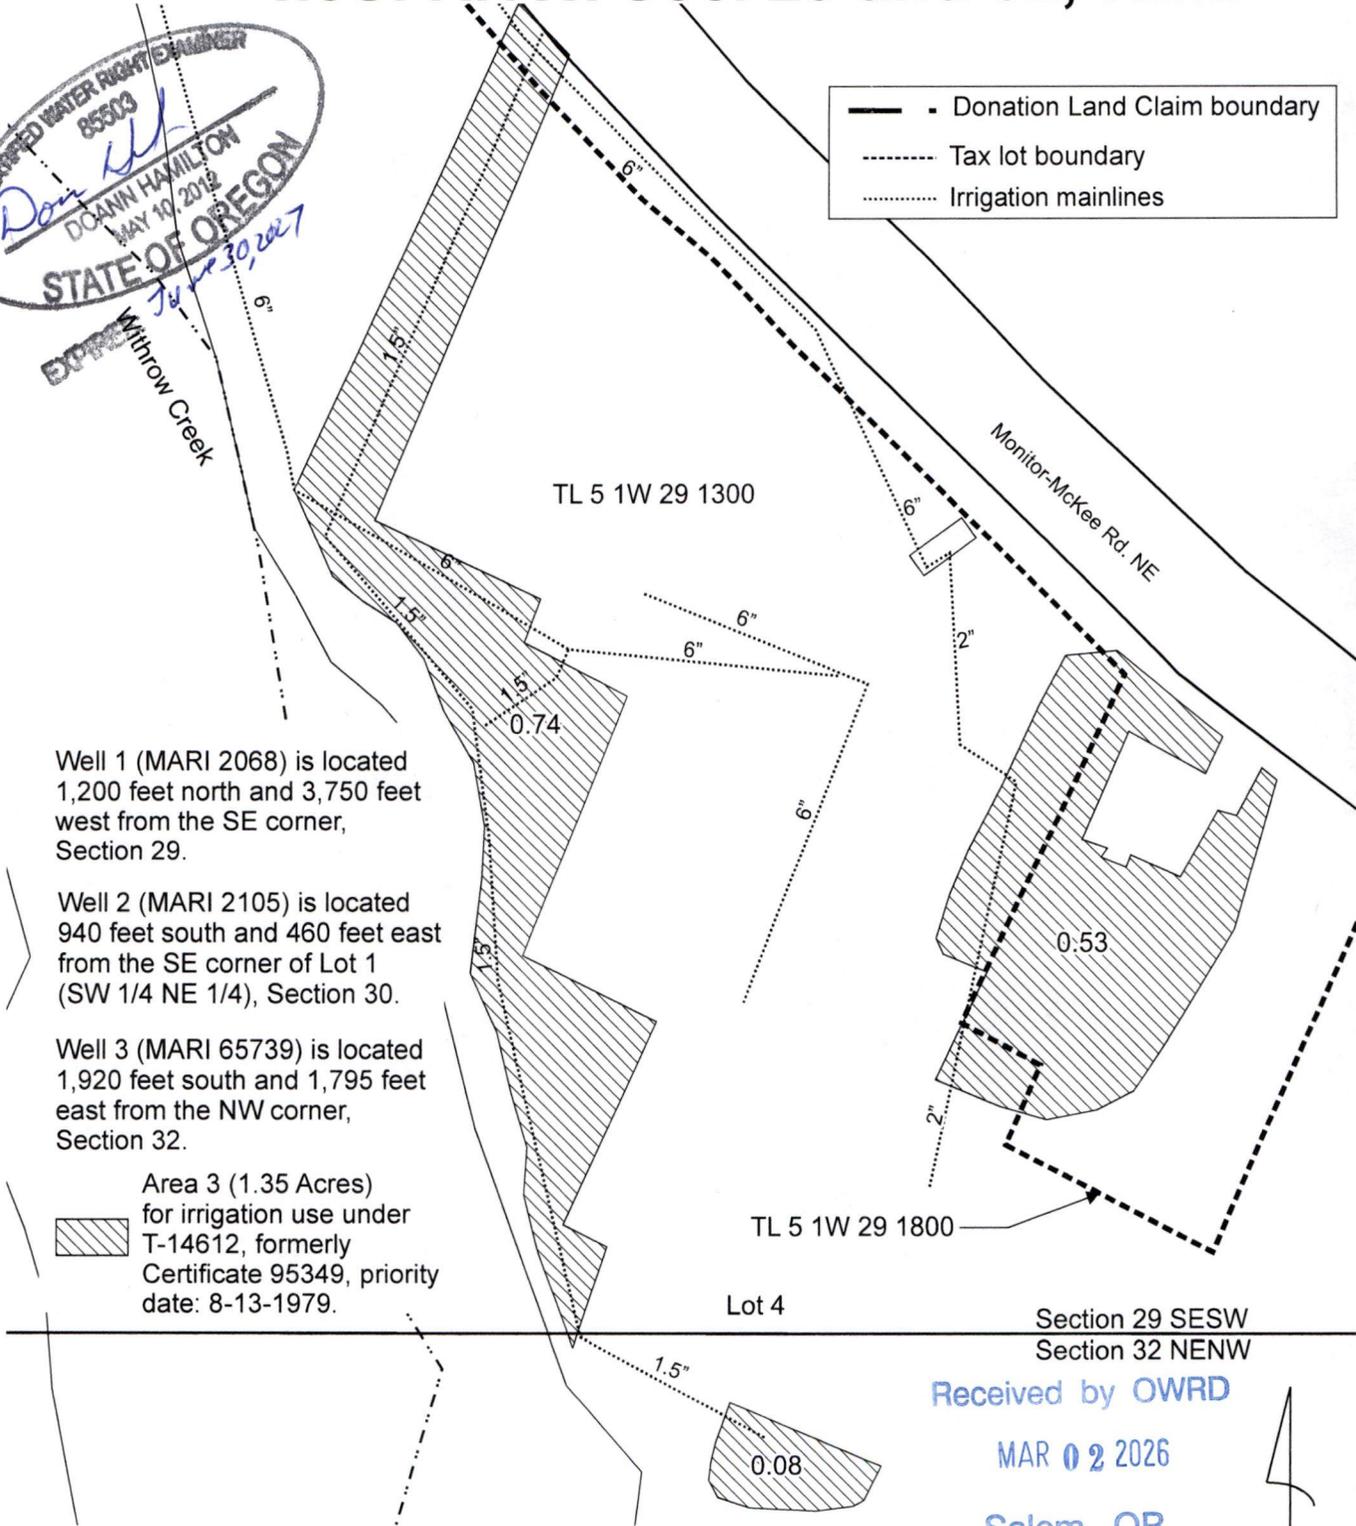


Well 1 (MARI 2068) is located 1,200 feet north and 3,750 feet west from the SE corner, Section 29.

Well 2 (MARI 2105) is located 940 feet south and 460 feet east from the SE corner of Lot 1 (SW 1/4 NE 1/4), Section 30.

Well 3 (MARI 65739) is located 1,920 feet south and 1,795 feet east from the NW corner, Section 32.

Area 3 (1.35 Acres) for irrigation use under T-14612, formerly Certificate 95349, priority date: 8-13-1979.

Received by OWRD
 MAR 02 2026
 Salem, OR

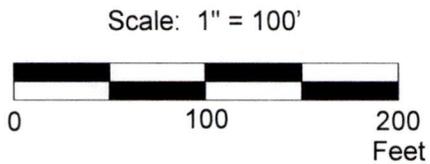

This map was prepared for the purpose of identifying the location of a water right only and is not intended to provide legal dimensions or location of property ownership lines.

Claim of Beneficial Use Map: Area 3
 T-14612 formerly Certificate 95349

Treco Investments LLC
 T.5S. R.1W. Sec. 29 and 32, W.M.

TrecoT-14612COBUArea3Map.cdr



02/2026

T.5S. R.1W. Section 32, W.M.

NENW NWNE
SESW SWNE

TL 5 1W 32 800


Well 1 (MARI 2068) is located 1,200 feet north and 3,750 feet west from the SE corner, Section 29.

Well 2 (MARI 2105) is located 940 feet south and 460 feet east from the SE corner of Lot 1 (SW 1/4 NE 1/4), Section 30.

Well 3 (MARI 65739) is located 1,920 feet south and 1,795 feet east from the NW corner, Section 32.

 Area 4 (0.5 Acres) for irrigation use under T-14612, formerly Certificate 95349, priority date: 8-13-1979.

-  Donation Land Claim boundary
-  Tax lot boundary
-  Irrigation mainlines

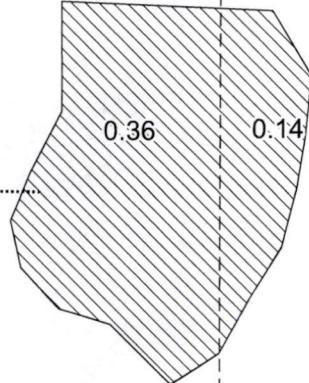

6" PVC

4"


8"

CERTIFIED WATER RIGHT EXAMINER
85503
Doann Hamilton
DOANN HAMILTON
MAY 10, 2012
STATE OF OREGON
EXPRES: June 30, 2017

Received by OWRD
MAR 02 2026
Salem, OR



Scale: 1" = 100'

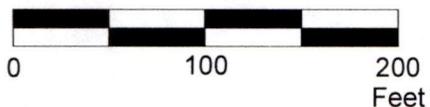

This map was prepared for the purpose of identifying the location of a water right only and is not intended to provide legal dimensions or location of property ownership lines.


Claim of Beneficial Use Map: Area 4
T-14612, formerly Certificate 95349

Treco Investments LLC
T.5S. R.1W. Section 32, W.M.

 WILL MCGILL SURVEYING LLC

02/2026

TrecoT-14612COBUArea4Map.cdr

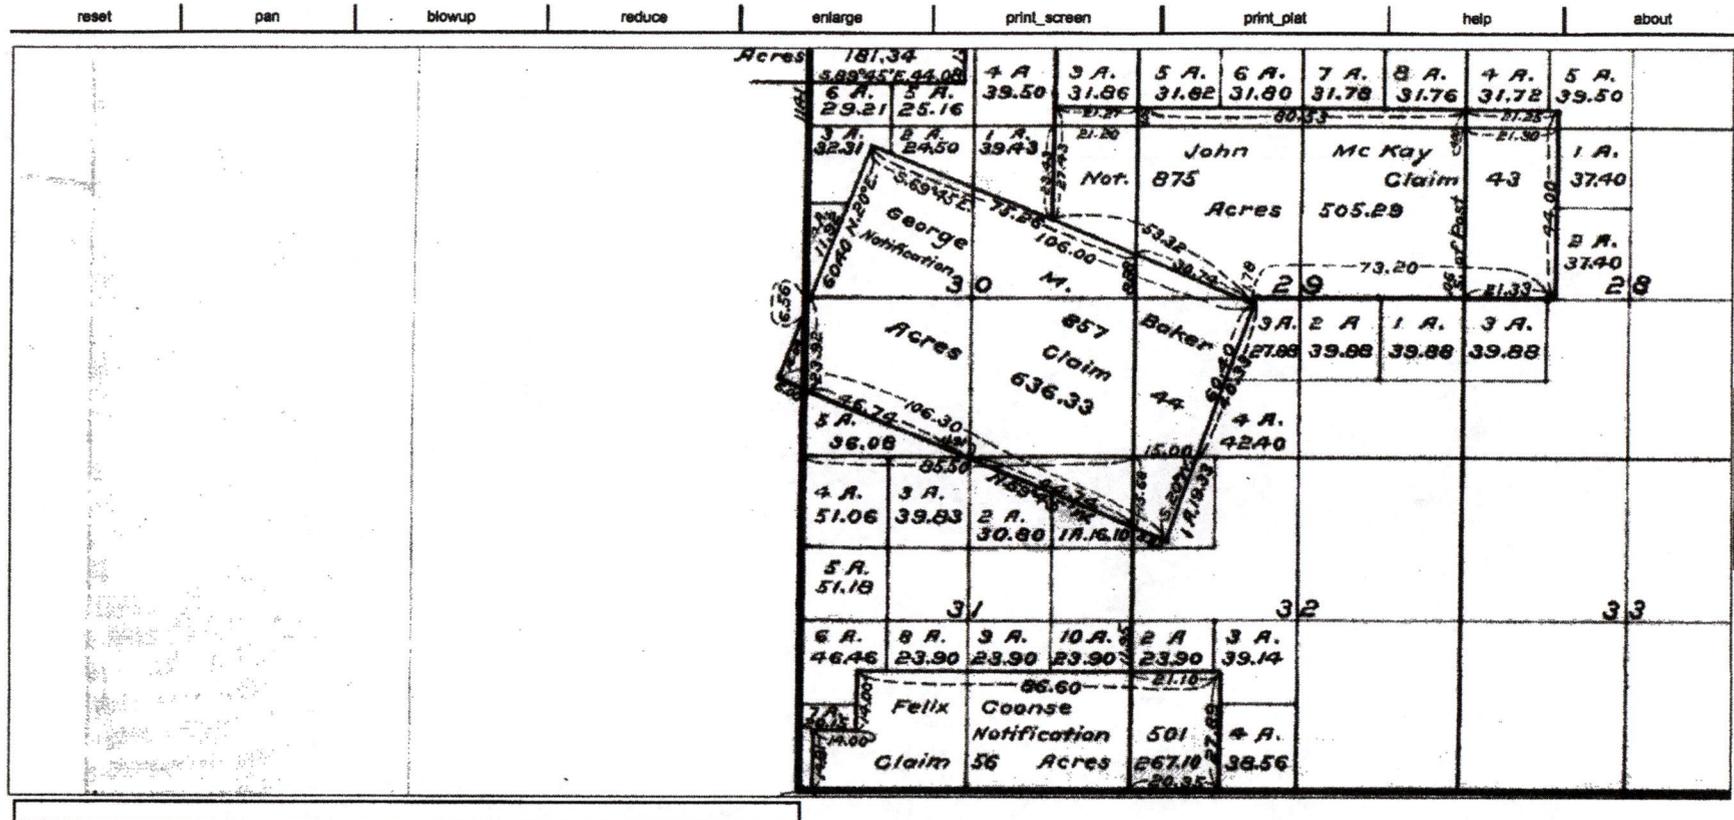

Received by OWRD
 MAR 02 2026
 Salem, OR