

T. 9S. R. 14W. W. M.

COOS COUNTY, STATE OF OREGON


PREPARED FOR: DAVE, MAVIS AND JEFFERY FRANSON
Rt. 2 Box 760
Bandon, OR 97411
(503)347-2355

PREPARED BY: PRAHAR SURVEYING
1045 BALTIMORE #1
BANDON, OR 97411
(503)347-9517

DATE: DECEMBER 29, 1992

MAP TO ACCOMPANY THE APPLICATION
FOR A SURFACE WATER REGISTRATION
STATEMENT PRE 1909 VESTED WATER
RIGHT CLAIM.

LEGEND:  Alum. Cap used
 Bear Creek
 Bear Creek Market Road
 Limits of stockwatering
 Section Lines
 1/4 Section Lines

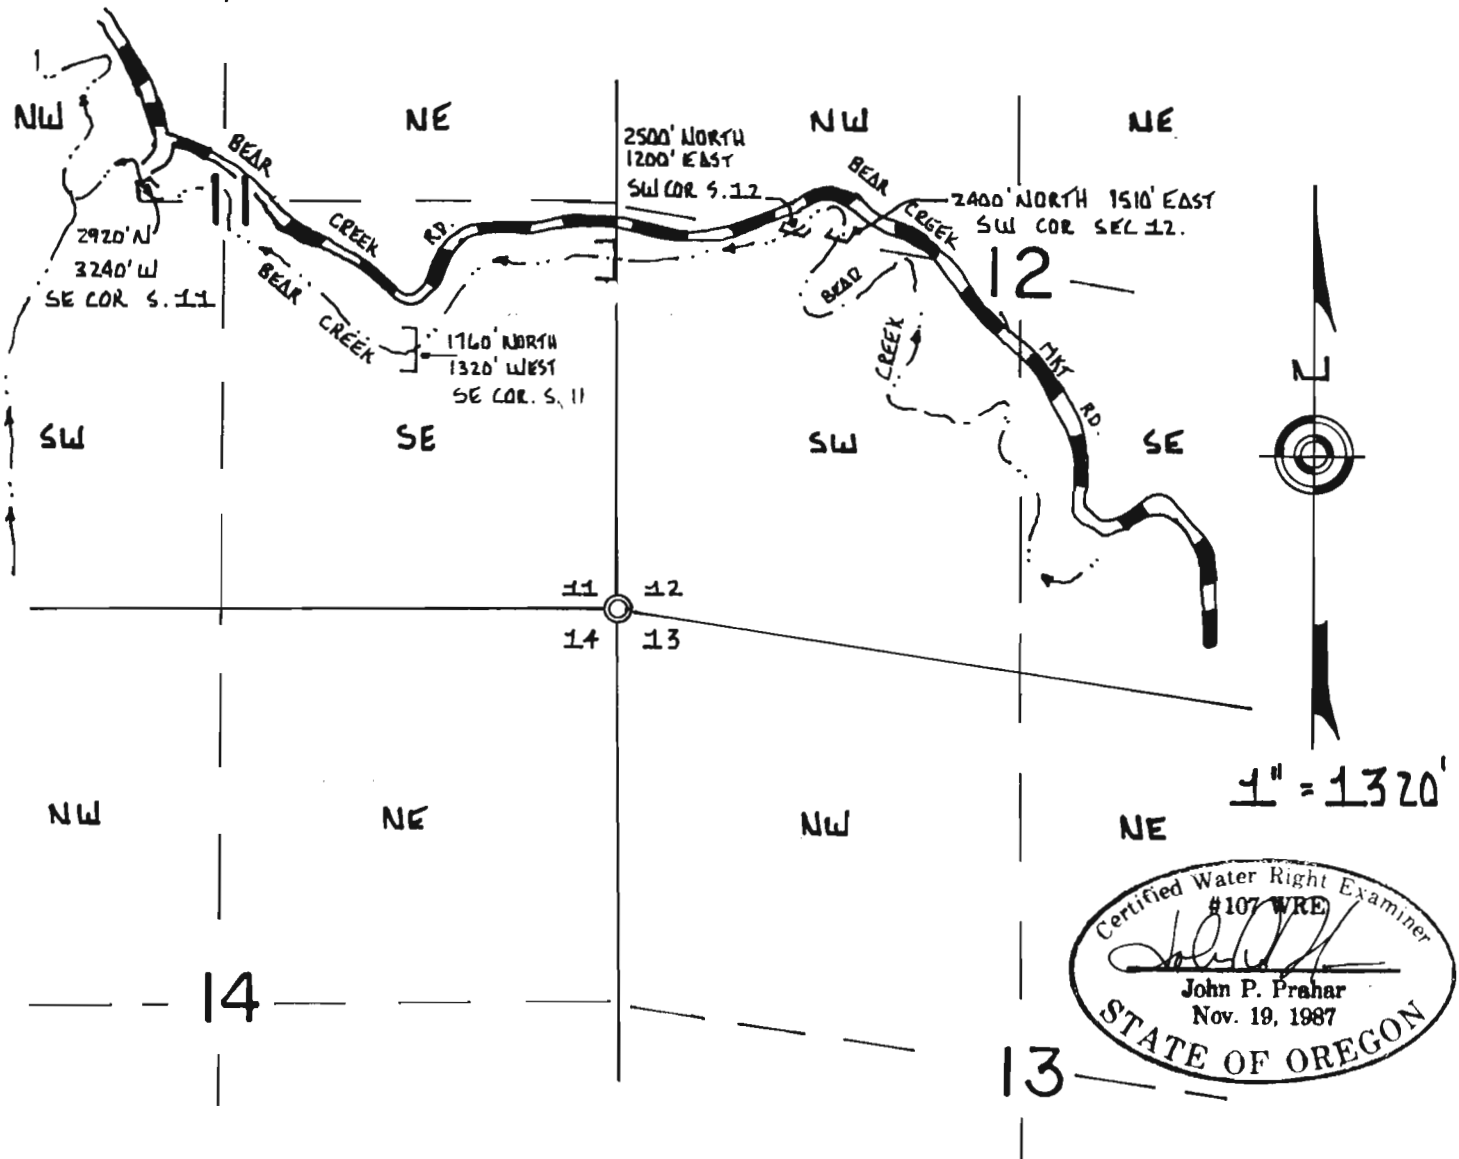

DISCLAIMER STATEMENT: This map was prepared for the sole purpose of locating a water right and is not intended to give legal dimensions or show property ownership lines.

RECEIVED

JAN 05 1993

WATER RESOURCES DEPT.
SALEM, OREGON

Watermaster's Office
District No. 19
Coos County Courthouse
Coquille, OR 97423

Receipt Dave Franson

Date: December 30, 1992

Amount: \$ 200⁰⁰.

Pre-1989 application form.

Received by:

Jerry L Woody

SURFACE WATER REGISTRATION CHECKLIST

(received after July 18, 1990)

CHECK BASIN MAP DNF NAME SOUTH COAST # 17 UNADJUDICATED AREA ? OK DNF
RECEIPT # 95983 S W R NUMBER 586
CHECK ENCLOSURES DNF PRELIMINARY DATA BASE ENTRY DNF
ACKNOWLEDGEMENT LETTER DNF ENTER ON STREAM INDEX _____
CHECK QUADRANGLE MAP _____ CHECK GLO PLATS _____
WATERMASTER CHECKLIST _____ PUBLIC NOTICE PUBLICATION SCN

FORM REVIEW

_____ blanks filled in
_____ signed
_____ date received stamped

MAP REVIEW

✓ source and trib
_____ diversion point location
_____ conveyances (pipes, ditch, etc.)
_____ place of use
✓ scale
✓ township, range, section
_____ north arrow
✓ CWRE stamp
✓ disclaimer
✓ date survey was performed
✓ P.O.B. of survey
_____ dimensions and capacity of diversion system
_____ "beneficial use" type title
✓ "permanent-quality" paper

WATER RIGHT RECORD CHECK _____ FIELD INSPECTION _____
FINAL FILE REVIEW _____ FINAL DATA BASE ENTRY _____
ENTER ON PLAT CARDS _____

February 25, 1994

JOHN P PRAHAR
1045 BALTIMORE AVE #1
BANDON OR 97411

RE: SWR-586

Dear Mr Prahar,

This will acknowledge the receipt of map to support the pre-1909 vested water right claim in the name of DAVE, MAVIS AND JEFFERY FRANSON you returned with corrections and completions. I have added the map to the file. Thank you for your attention to this matter. If you have any questions, please give me a call.

Sincerely,



Don Knauer
Adjudication Specialist

J:\W\SI\SI\SWR-0586.002



3850 Portland Rd NE
Salem, OR 97310
(503) 378-3739
FAX (503) 378-8130

January 27, 1994

WATER
RESOURCES
DEPARTMENT

JOHN P. PRAHAR
1045 BALTIMORE AVE. #1
BANDON OR 97411

RE: File# SWR-586

DEAR JOHN P. PRAHAR,

I am returning the map you prepared for Dave, Mavis and Jeffery Franson. You will find the item which requires completion or correction shown below. I have the description followed by the ORS or OAR site and paraphrased statute or rule.


place of use ($\frac{1}{4}$ $\frac{1}{4}$)

ORS 539.240 (2) (d) (B) "The location of place of use by quarter-quarter section..." You must show the 1/16th lines.

You must return the map before the claim can be processed. If you cannot have the map to the WRD within 60 days, please inform me as to when it can be expected. Please mark all correspondence with the file number.

As always, if you have any questions, please give me a call.

Sincerely,

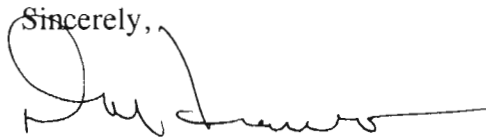

Don Knauer
Adjudication Specialist

Enclosures

J:\WP51\SWR\CLAIMANT\5\SWR-0586.00M



3850 Portland Rd NE
Salem, OR 97310
(503) 378-3739
FAX (503) 378-8130

May 4, 1993

DAVE, MAVIS AND JEFFERY FRANSON
RT 2 BOX 760
BANDON OR 97411


Dear DAVE, MAVIS AND JEFFERY FRANSON,

This will acknowledge that your Surface Water Registration Statement in the name of DAVE, MAVIS AND JEFFERY FRANSON has been received by our office. The fees in the amount of \$200.00 have been received and our receipt #95983 is enclosed. Your registration statement has been numbered SWR-586.

Our office will review your form and map in the near future. If necessary we will schedule a meeting with you that will include a site inspection. If there are problems with your form we are usually able to take care of them during our visit. We will be able to answer any questions you might have about the adjudication process at that time.

Please feel free to contact this office if you have any questions.

Sincerely,

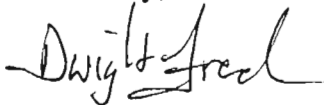

Dwight French
Adjudication Section

Enclosure

J:\WP51\SWR\CLAIMANT\5\SWR-0586.001



3850 Portland Rd NE
Salem, OR 97310
(503) 378-3739
FAX (503) 378-8130

STATE OF OREGON

WATER RESOURCES DEPARTMENT

RECEIPT # 95983

3850 PORTLAND ROAD NE

SALEM, OR 97310

378-8455/378-8130 (FAX)

RECEIVED FROM:

BY:

APPLICATION

PERMIT

TRANSFER

CASH:

CHECK: #

OTHER: (IDENTIFY)

TOTAL REC'D

\$ 200

01-00-0 WRD MISC CASH ACCT

842.010 ADJUDICATIONS

831.087 PUBLICATIONS/MAPS

830.650 PARKING FEES Name/month

OTHER: (IDENTIFY)

\$ 200

\$

\$

\$

REDUCTION OF EXPENSE

CASH ACCT.

COST CENTER AND OBJECT CLASS

VOUCHER #

\$

03-00-0 WRD OPERATING ACCT

MISCELLANEOUS:

840.001 COPY FEES

850.200 RESEARCH FEES

880.109 MISC REVENUE: (IDENTIFY)

520.000 OTHER (P-6): (IDENTIFY)

\$

\$

\$

\$

WATER RIGHTS:

842.001 SURFACE WATER

842.003 GROUND WATER

842.005 TRANSFER

WELL CONSTRUCTION

842.022 WELL DRILL CONSTRUCTOR

842.016 WELL DRILL OPERATOR

LANDOWNER'S PERMIT

EXAM FEE

\$

\$

\$

EXAM FEE

\$

\$

842.002

842.004

842.006

842.023

842.019

842.024

RECORD FEE

\$

\$

\$

LICENSE FEE

\$

\$

\$

06-00-0 WELL CONST START FEE

842.013 WELL CONST START FEE

MONITORING WELLS

\$

\$

CARD #

CARD #

45-00-0 LOTTERY PROCEEDS

864.000 LOTTERY PROCEEDS

\$

07-00-0 HYDRO ACTIVITY

LIC NUMBER

842.011 POWER LICENSE FEE(FW/WRD)

842.115 HYDRO LICENSE FEE(FW/WRD)

\$

\$

HYDRO APPLICATION

\$

RECEIPT #

95983

DATED:

1-6-93

BY:

P. Bushnell

Distribution—White Copy-Customer, Yellow Copy-Fiscal, Blue Copy-File, Buff Copy-Fiscal