



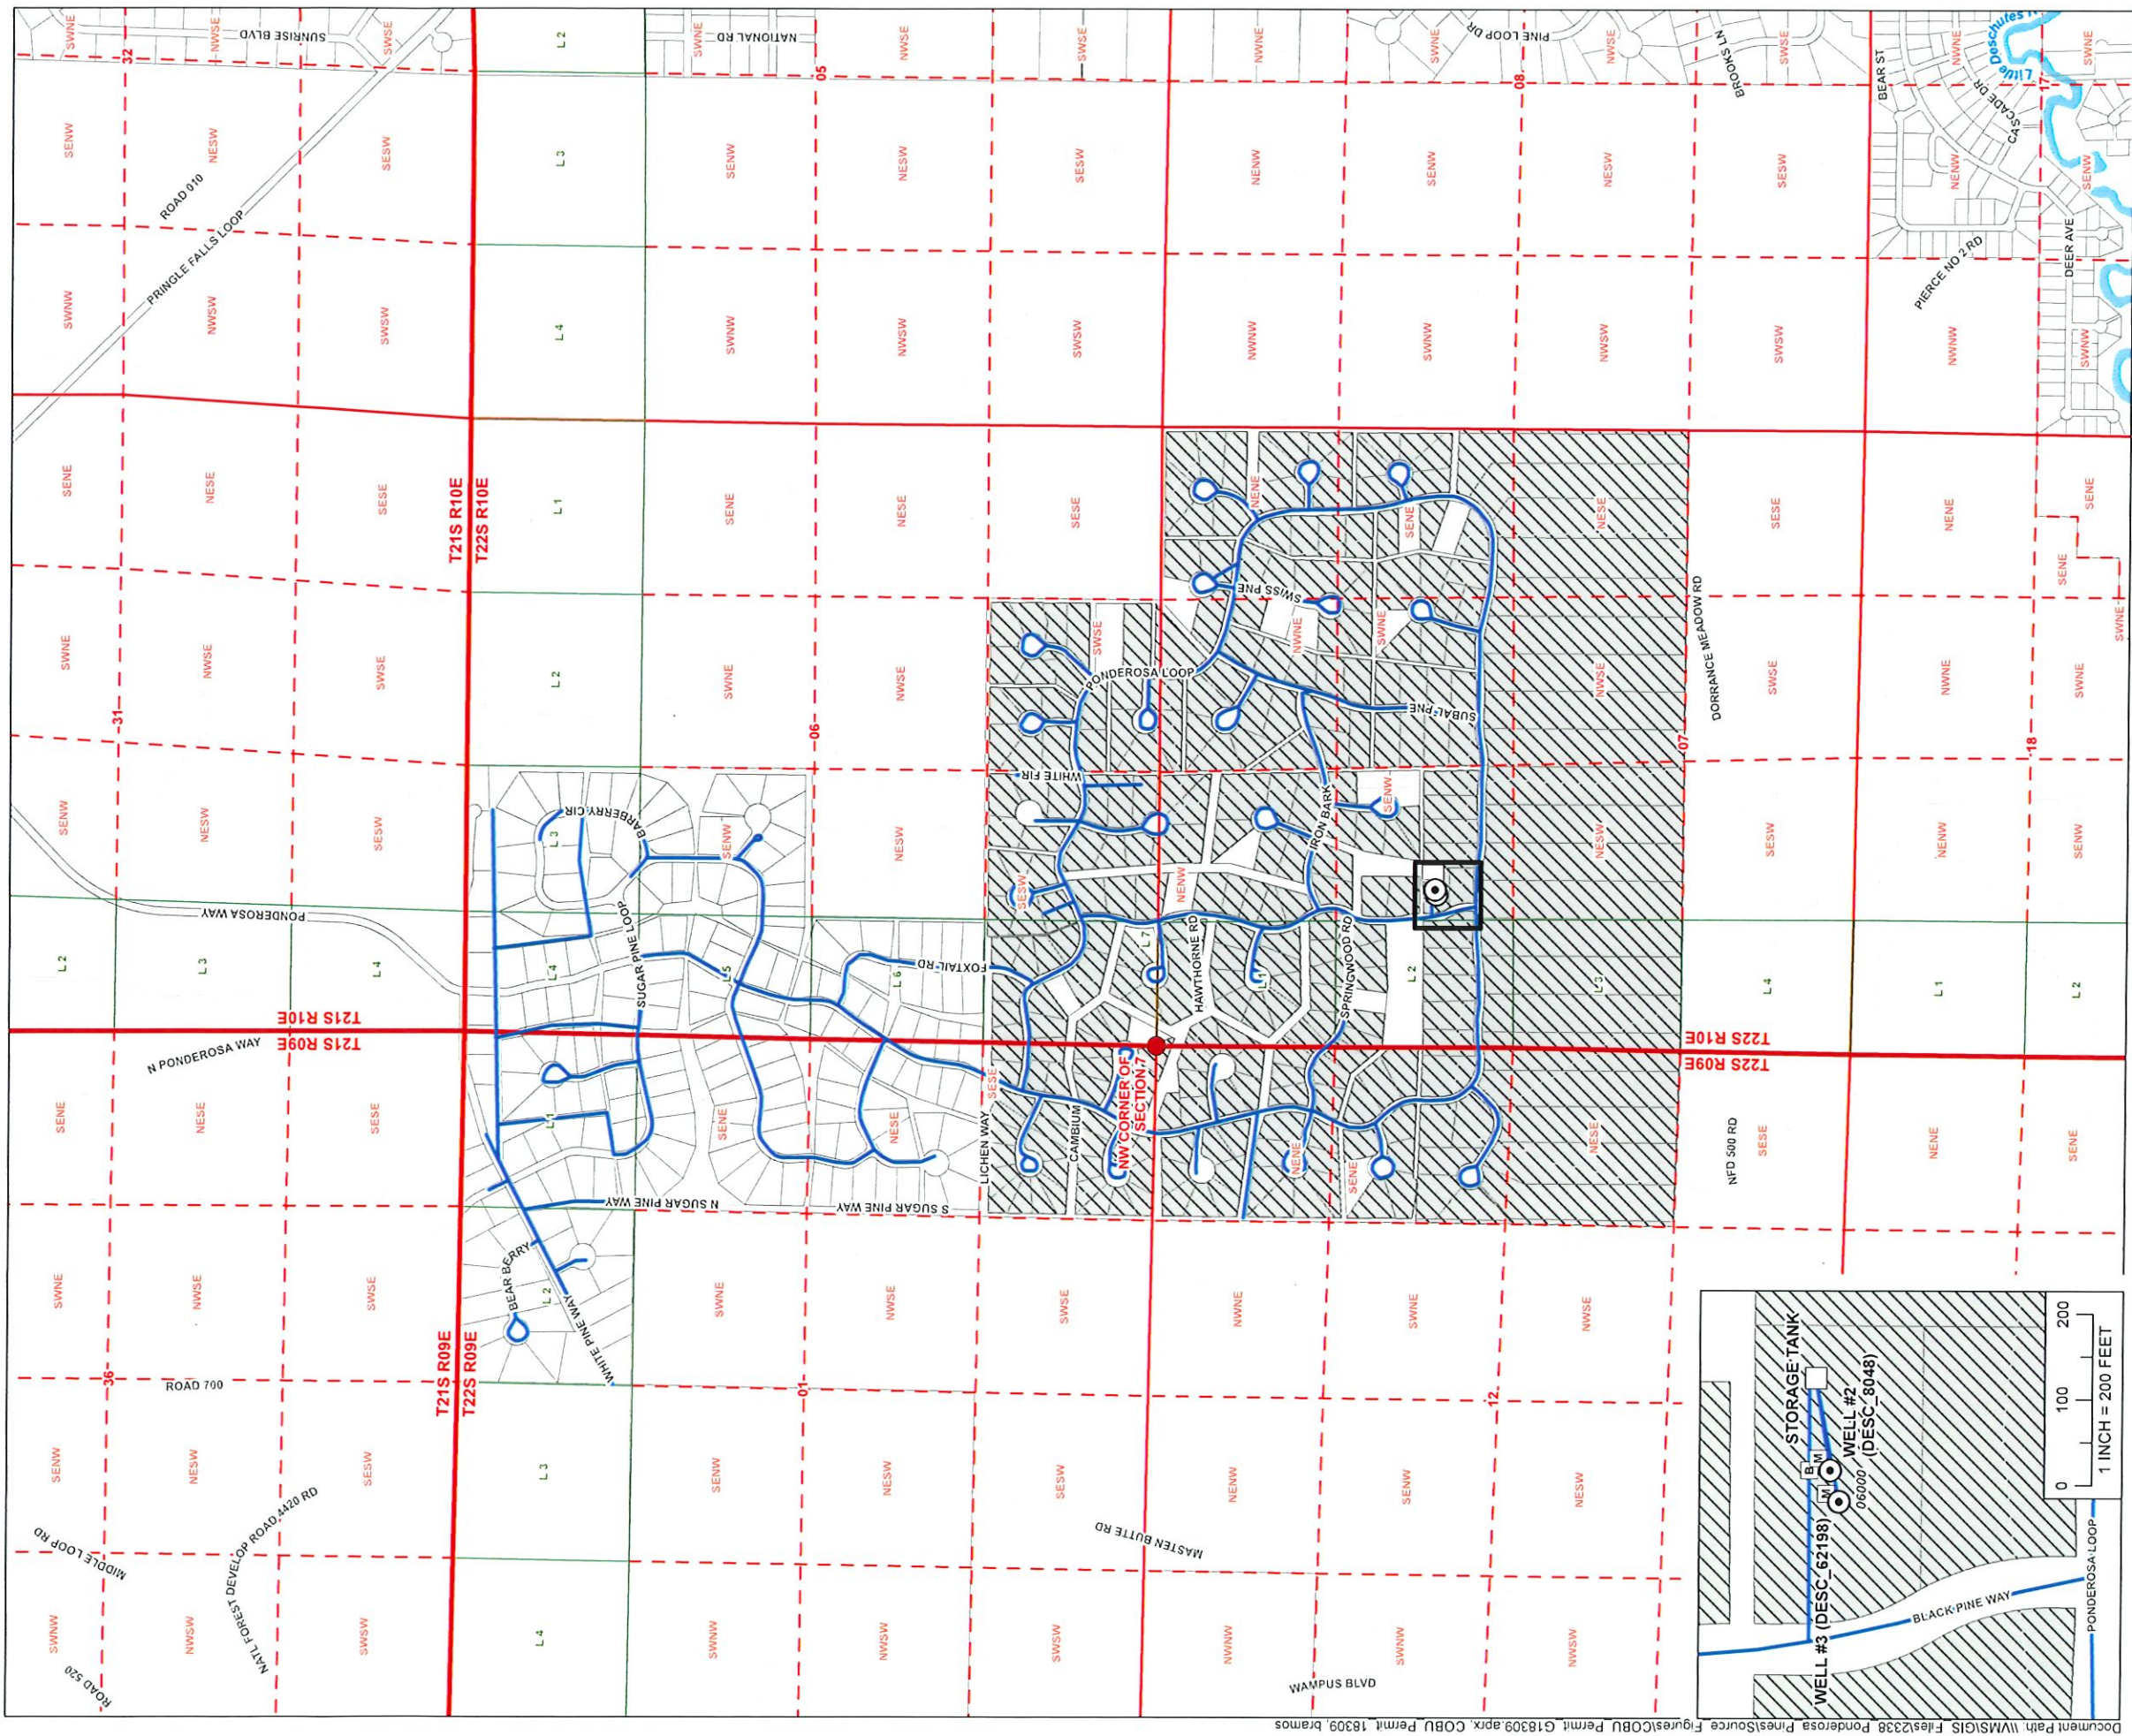

LEGEND

- POA
- Meter
- Booster Pumps
- Storage Tank
- Conveyance
- Place of Use (POU) (286 Lots)
- Tax Lot
- Government Lot (GL)
- Watercourse

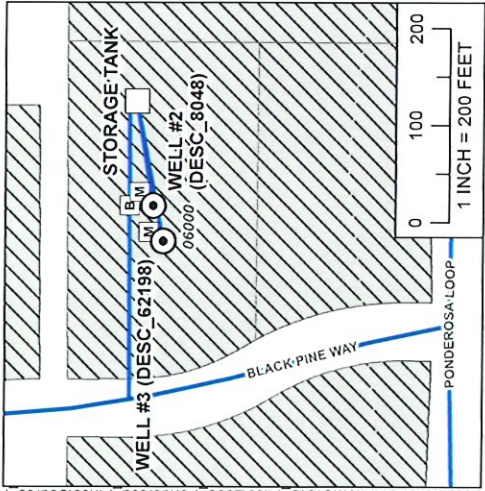

Claim of Beneficial Use Map
Ponderosa Pines Water Company
Application G-9118
Permit G-18309
Township 22 South, Ranges 9 and 10 East (W.M.)

CERTIFIED WATER RIGHTS EXAMINER STAMP



LOCATION DESCRIPTION
Well #2 (DESC. 8048)
Located 2,106 feet South and 1,191 feet East from the NW corner of Section 7, Township 22 South, Range 10 East (W.M.)
Meter Location: Approximately 5 feet from well in the well house.
Well #3 (DESC. 62198)
Located 2,108 feet South and 1,161 feet East from the NW corner of Section 7, Township 22 South, Range 10 East (W.M.)
Meter Location: Approximately 5 feet from well in the well house.

Received
MAR 10 2026
OWRD

DISCLAIMER
This map was prepared for the purpose of identifying the location of a water right only and it is not intended to provide legal dimensions or location of property ownership lines.
Date: February 16, 2026
Data Sources: BLM, ESRI, OWRD, USGS

