

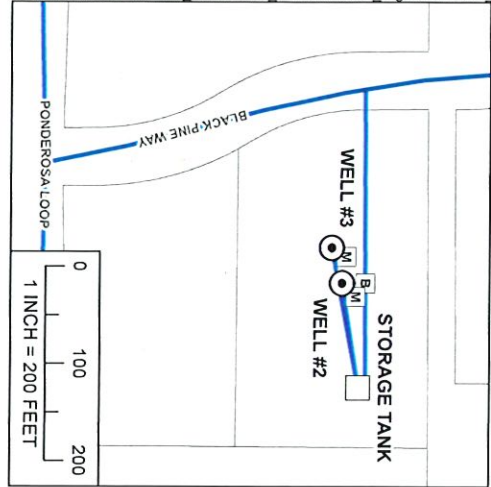


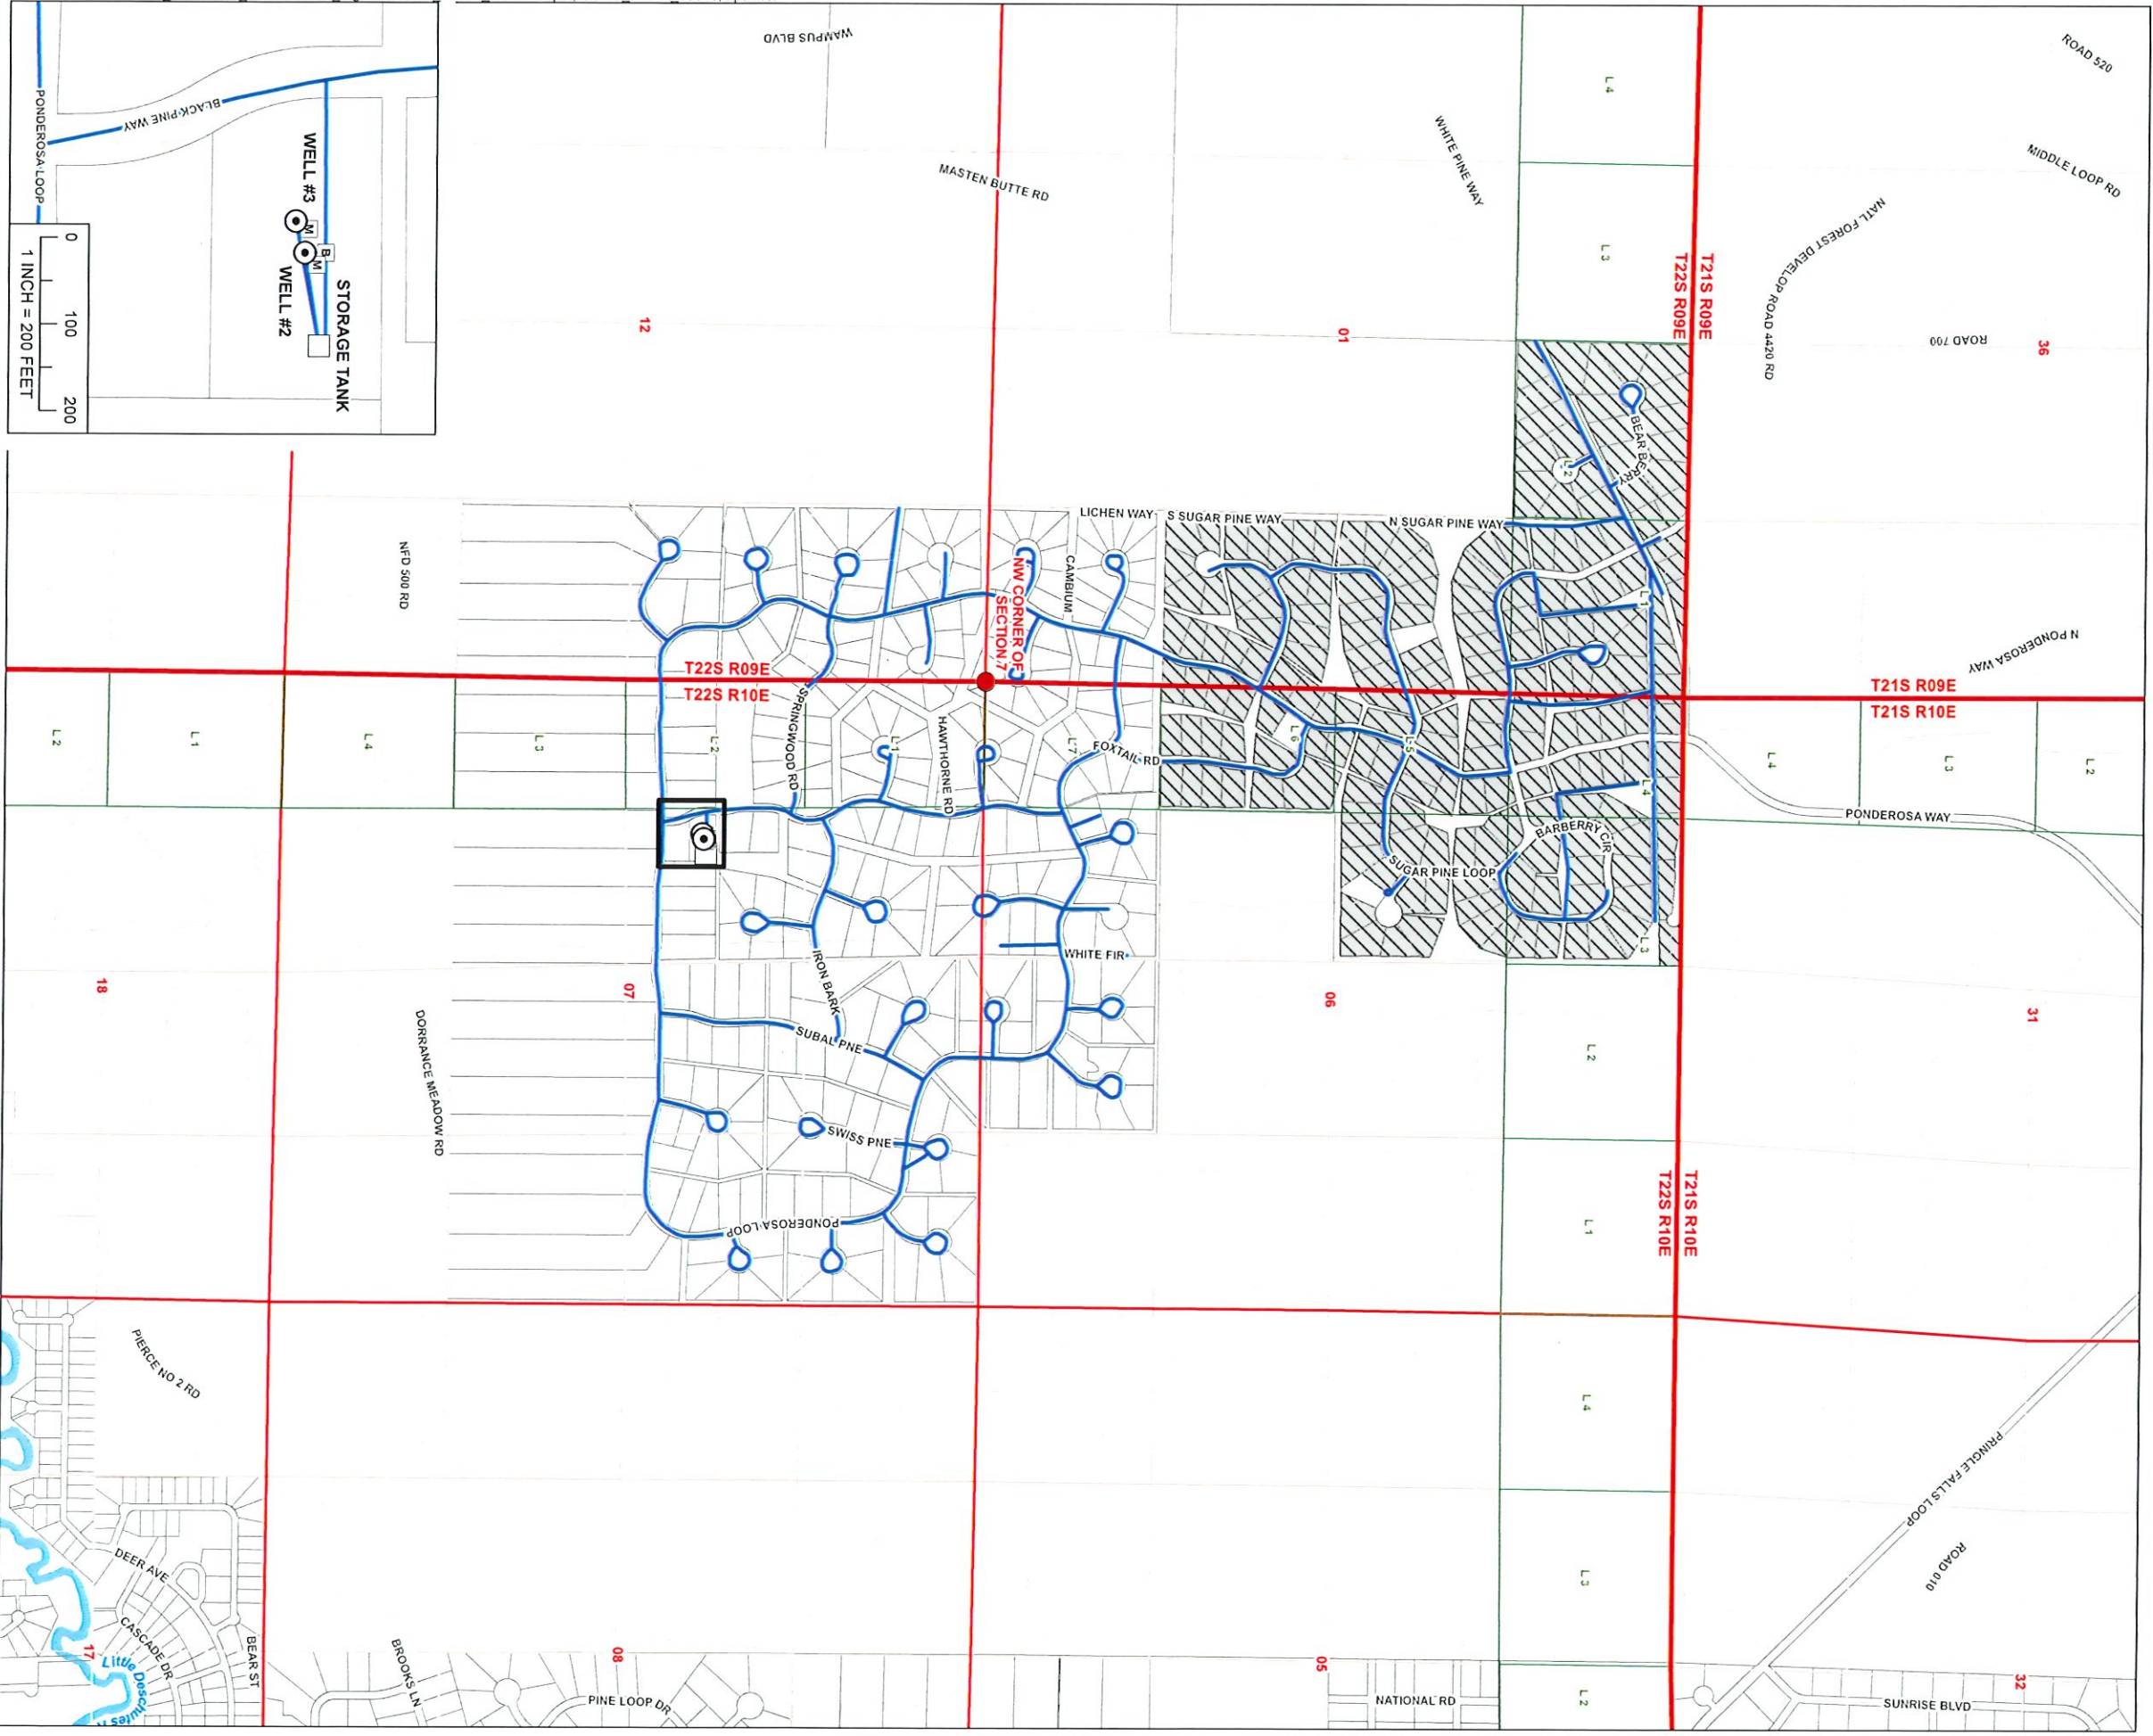

- LEGEND**
- POA
 - Meter
 - Booster Pump
 - Storage Tank
 - Conveyance
 - Place of Use (POU)
 - Tax Lot
 - Government Lot (GL)
 - Watercourse
 - Waterbody

CERTIFIED WATER RIGHTS EXAMINER STAMP

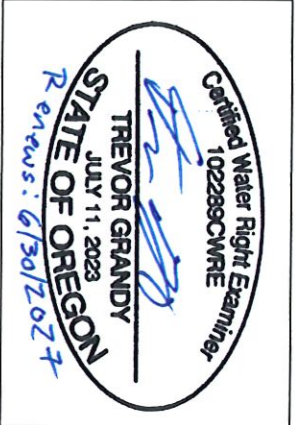

LOCATION DESCRIPTION

Well #2
Located 2,106 feet South and 1,191 feet East from the NW corner of Section 7, Township 22 South, Range 10 East (W.M.)

Well #3
Located 2,108 feet South and 1,161 feet East from the NW corner of Section 7, Township 22 South, Range 10 East (W.M.)

Received

MAR 10 2026

OWRD

Township 22 South, Ranges 9 and 10 East (W.M.)

Claim of Beneficial Use Map
Ponderosa Pines Water Company

Application G-7020
Permit G-18310

DISCLAIMER
This map was prepared for the purpose of identifying the location of a water right only and it is not intended to provide legal dimensions or location of property ownership lines.
Date: January 6, 2026
Data Sources: BLM, ESRI, OWRD, USGS



0 660 1,320 1,980
1 INCH = 1,320 FEET



Water Solutions, Inc.