
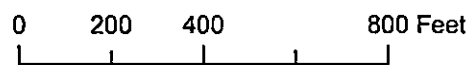


Claim of Beneficial Use - Firestone Application R-86576, Permit R-14296

Township 6S, Range 5W, W.M.

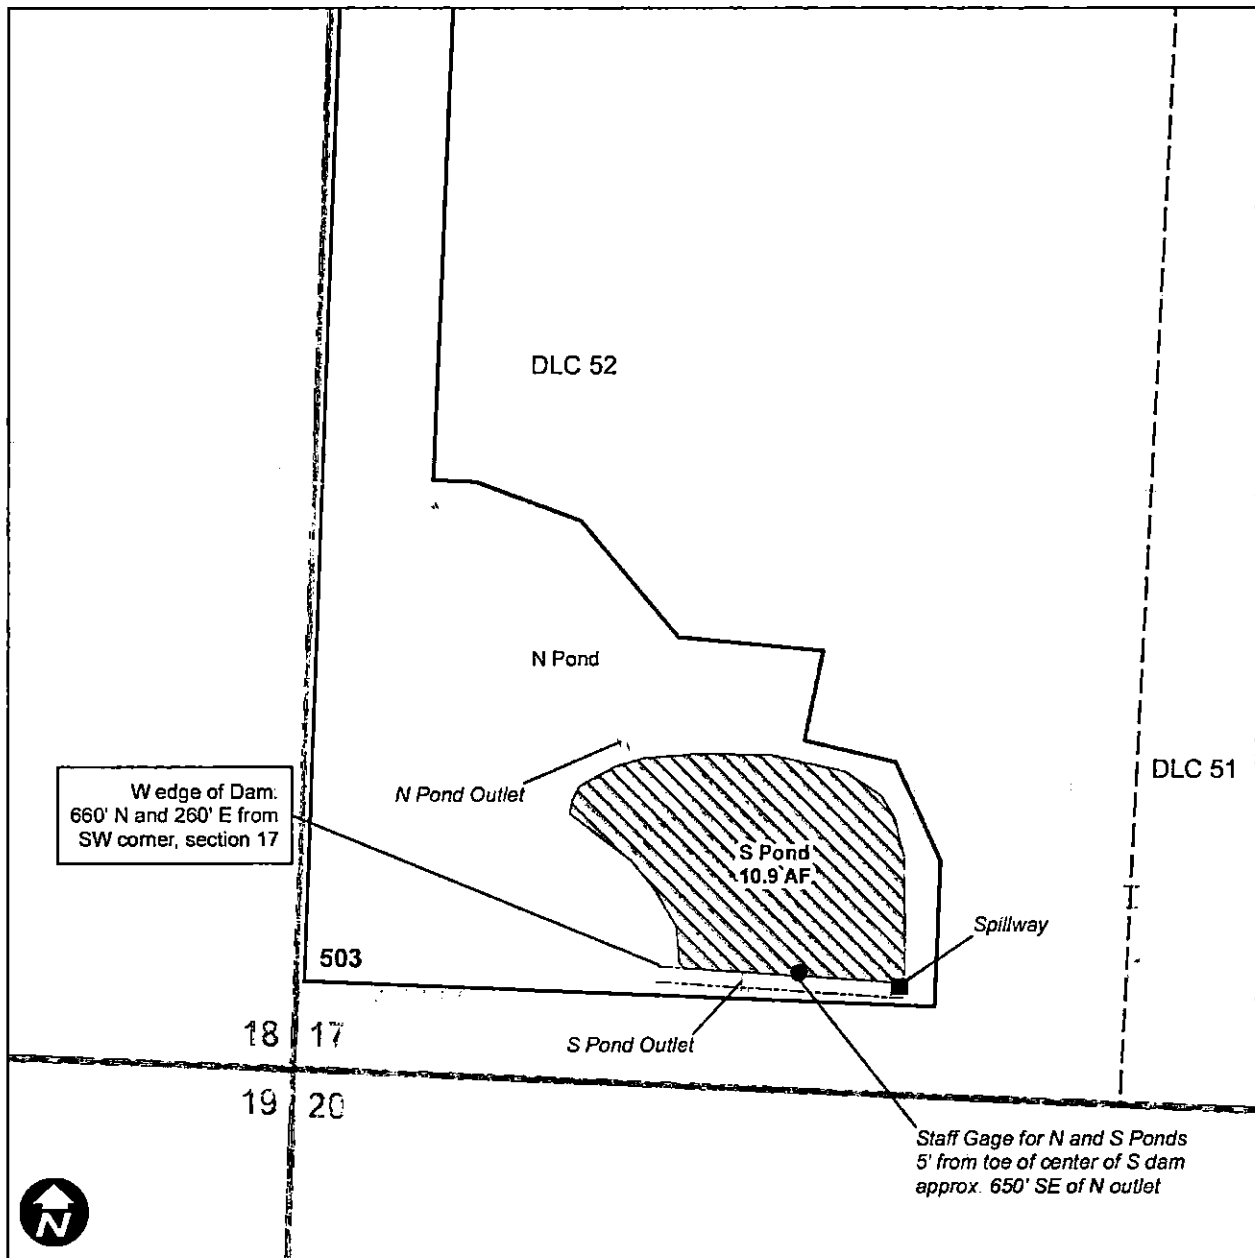

This map is not intended to provide legal dimensions or locations of property ownership lines.

- Legend**
- S Pond - POU
 - Dam
 - Taxlot
 - DLC

