


T.3S. R.2W. Section 27, W.M.

22 | 23
27 | 26

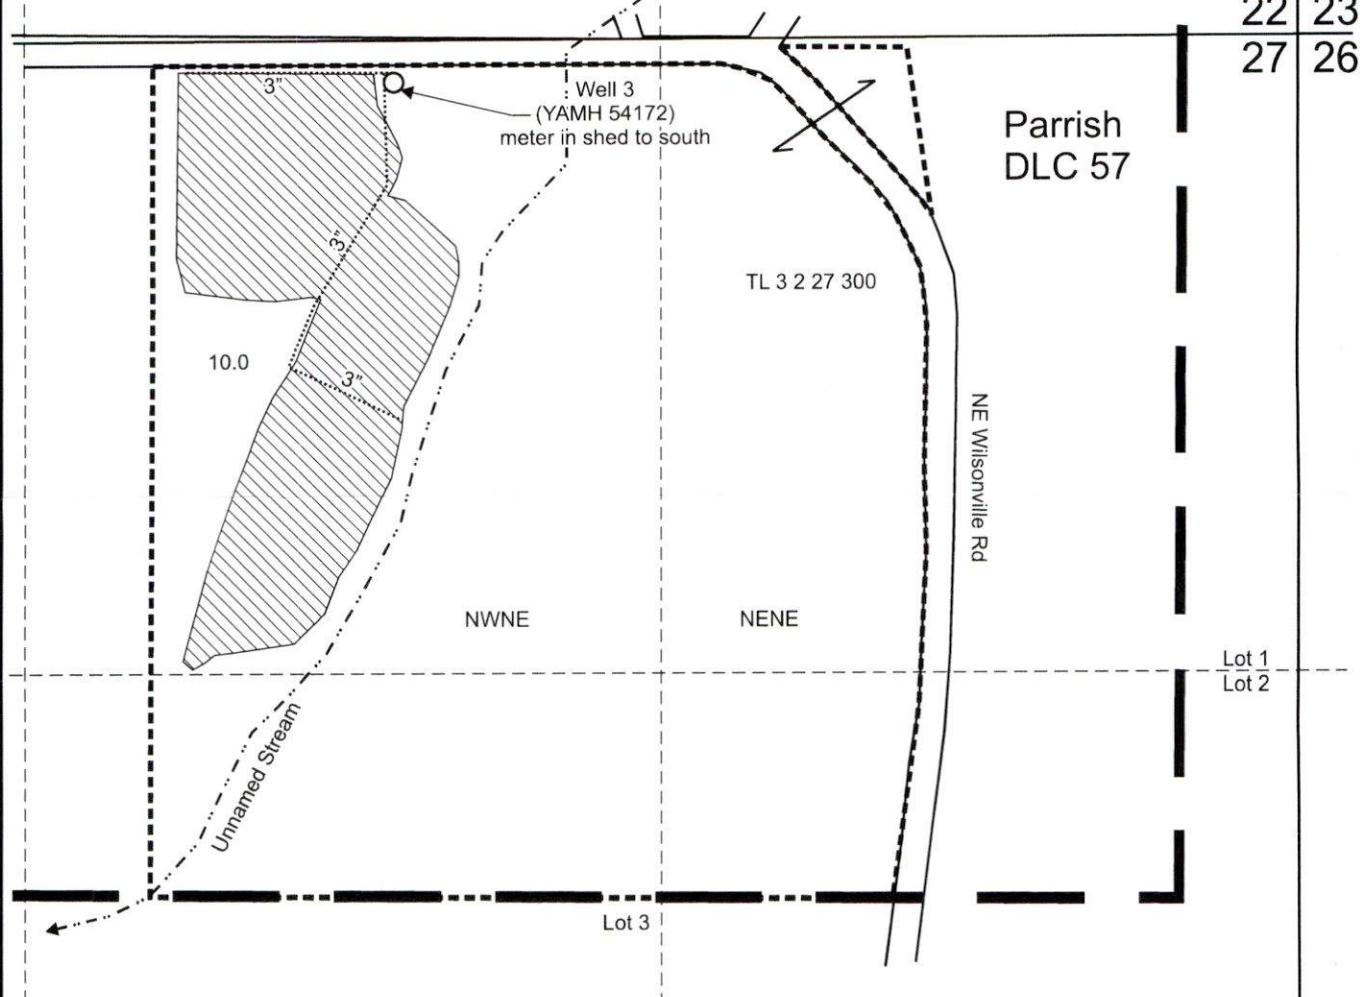

Parrish
DLC 57

TL 3 2 27 300

NE Wilsonville Rd

NWNE

NENE

Lot 1
Lot 2

Lot 3

Well 3 (YAMH 54172) is located 90 feet south and 1,875 feet west from the NE corner, Section 27.

Area (10.0 Acres) irrigated under Application G-16139, Permit G-15736.

Tax lot boundary


Donation Land Claim boundary

Water main line


Received by OWRD

MAR 20 2026

Salem, OR

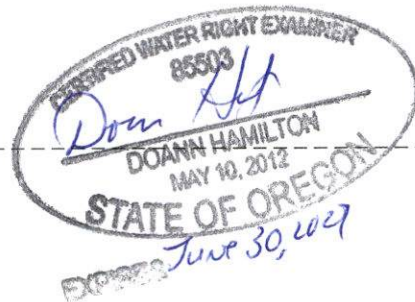

Scale: 1" = 400'

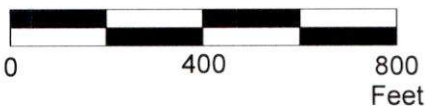

This map was prepared for the purpose of identifying the location of a water right only and is not intended to provide legal dimensions or location of property ownership lines.

Claim of Beneficial Use Map
Application G-16139, Permit G-15736

Halsey Resources LLC
T.3S. R.2W. Section 27, W.M.

WILL MCGILL SURVEYING LLC

02/2026