



United States Department of the Interior

BUREAU OF RECLAMATION
1150 North Curtis Road
Boise, ID 83706-1234



IN REPLY REFER TO:

CPN-6323
2.2.4.23

MAR 25 2026

E-RECEIVED
MAR 25, 2026
OWRD

Mark and Kim E. Lawler
45955 Oak St.
Lyons, OR 97358

Subject: Successor in Interest to Water Service Contract No. 1-07-10-W0818, Willamette River Basin Project, Oregon

Dear Mr. and Mrs. Lawler:

Enclosed for your records is a fully executed original of the document that recognizes you as the successor in interest to Contract No. 1-07-10-W0818, dated December 7, 1990. If you have questions, please contact Ms. Joy Kelley, Repayment Specialist, at the above address, at (986) 999-8984, jkelly@usbr.gov, or me at (208) 378-5306 or emcgarry@usbr.gov. If you are deaf, hard of hearing, or have a speech disability, please dial 7-1-1 to access telecommunications relay services.

Sincerely,

E. Gail McGarry
Program Manager
Reclamation Law Administration

Enclosure

cc: U.S. Army Corps of Engineers
Kathryn.L.Warner@usace.army.mil
(w/encl)

Oregon Water Resources Department
Travis.N.Kelly@water.oregon.gov
(w/encl)

E-RECEIVED
MAR 25, 2026
OWRD

**RECOGNITION OF SUCCESSOR IN INTEREST TO WILLAMETTE BASIN
PROJECT WATER SERVICE CONTRACT NO. 1-07-10-W0818**

WHEREAS, the United States of America entered into a contract on December 7, 1990, Contract No. 1-07-10-W0818, (1990 Contract) with Hershel J. and Barbara A. Taylor for an irrigation water supply from the Willamette Basin Project for use on lands owned by the Contractor and described in the contract (Contract Land).


WHEREAS, the contract was subsequently assigned to Joseph S. Pillar on June 10, 2010.

WHEREAS, the contract was subsequently assigned to the Lyons Family Trust on March 8, 2023.


WHEREAS, the Contract Land has been conveyed by warranty deed to Mark and Kim E. Lawler, and Mark and Kim E. Lawler request that they be assigned the 1990 Contract.

NOW, THEREFORE, all right, title and interest in Contract No. 1-07-10-W0818, is hereby assigned to Mark and Kim E. Lawler. The Contract provides for an irrigation water supply not to exceed 5.625 acre-feet annually and limited to the place of use on 2.25 acres provided on the attached map, Exhibit A. This assignment is effective only upon the approval by the United States of America as provided in General Provisions, Article 16(f) of the 1990 Contract. Any notice, demand, or request authorized or required by this contract action shall be deemed to have been given, on behalf of the Contractor, when mailed, postage prepaid, or delivered to the Program Manager, Reclamation Law Administration, Columbia-Pacific Northwest Region, Bureau of Reclamation, 1150 Curtis Road, Boise, ID 83706-1234, and on behalf of the United States, when mailed, postage prepaid, or delivered to **Mark and Kim E. Lawler, 45955 Oak St., Lyons, OR 97358**. The designation of the addressee or the address may be changed by notice given in the same manner as provided in this clause.

CONTRACTOR

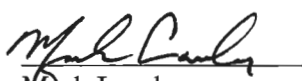

Mark Lawler

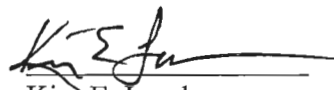3/17/2026
Date


Kim E. Lawler

3/17/2026
Date

The above contract action is hereby approved:


E. Gail McGarry, Program Manager
Reclamation Law Administration
Bureau of Reclamation

March 25, 2026
Date

Notary Public - Oregon
Commission No. 1041676
My Commission Expires November 5, 2027

E-RECEIVED
MAR 25, 2026
OWRD


STATE OF Oregon

County of Marion

OFFICIAL STAMP

On this 17th day of March, 2026, personally appeared before me, **Mark Lawler and Kim E. Lawler**, known to me to be the persons that executed the within and foregoing instrument and acknowledged they are the legal owners of the property for which a water supply is to be provided under Contract No. 1-07-10-W0818.

IN WITNESS WHEREOF, I have hereunto set my hand and affixed my official seal as of the day and year first above written.

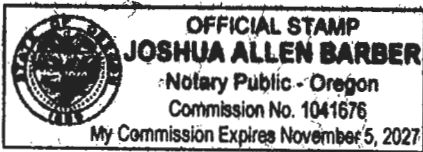

Joshua Allen Barber
Notary Public in and for the
State of Oregon
Residing at: 1740 Shuff Rd Stayton OR 97383
My commission expires: 11/5/2027

(SEAL)

STATE OF IDAHO

County of Ada

On this 25th day of March, 2026, personally appeared before me Elizabeth Gail McCarty, known to me to be the official of the UNITED STATES OF AMERICA that executed the within and foregoing instrument, and has acknowledged said instrument to be the free and voluntary act and deed of said United States, for the uses and purposes therein mentioned, and on oath stated that she was authorized to execute said instrument.

IN WITNESS WHEREOF, I have hereunto set my hand and affixed my official seal as of the day and year first above written.



Michael Cobell
Notary Public in and for the
State of IDAHO
Residing at: 1150 N. Curtis Rd Boise ID
My commission expires: 03/29/2029

(SEAL)


E-RECEIVED
MAR 25, 2026
OWRD

T.9S. R.2E.,W.M.

RECEIVED

AUG 11 1990

CLAYTON BISHOP, CLERK
SALMON, OREGON

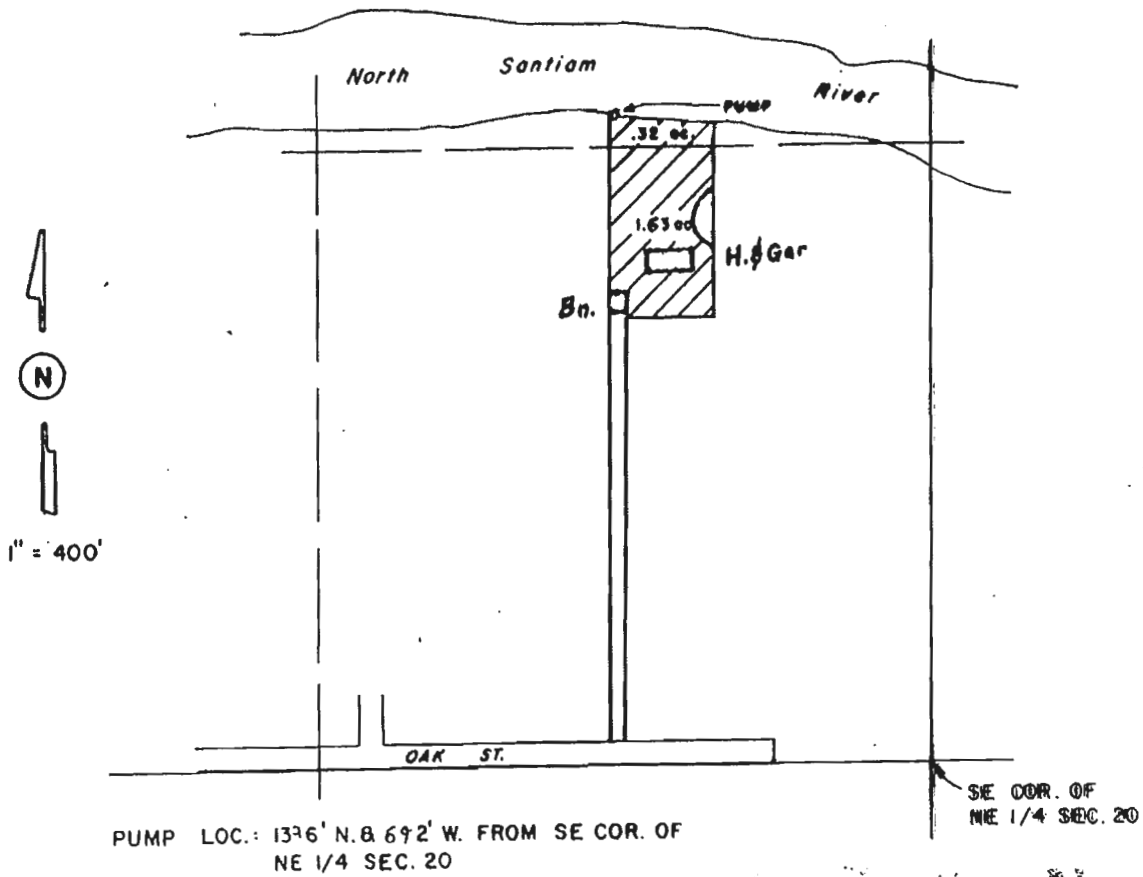

Application No. 70666
Permit No.

FINAL WATER RIGHT MAP FOR HERSHEL & BARBARA TAYLOR

SURVEYED ON AUG. 7, 1990

THIS MAP WAS PREPARED FOR THE PURPOSE OF IDENTIFYING THE LOCATION OF A WATER RIGHT ONLY AND IS NOT INTENDED TO PROVIDE LEGAL DIMENSIONS OR LOCATION OF PROPERTY OWNERSHIP LINES.

BY: *Larry W. Johnson*
LARRY W. JOHNSON
STATE OF OREGON
Certified Water Right Examiner
1229