



# T14S R13EWM Sec13 SWNE

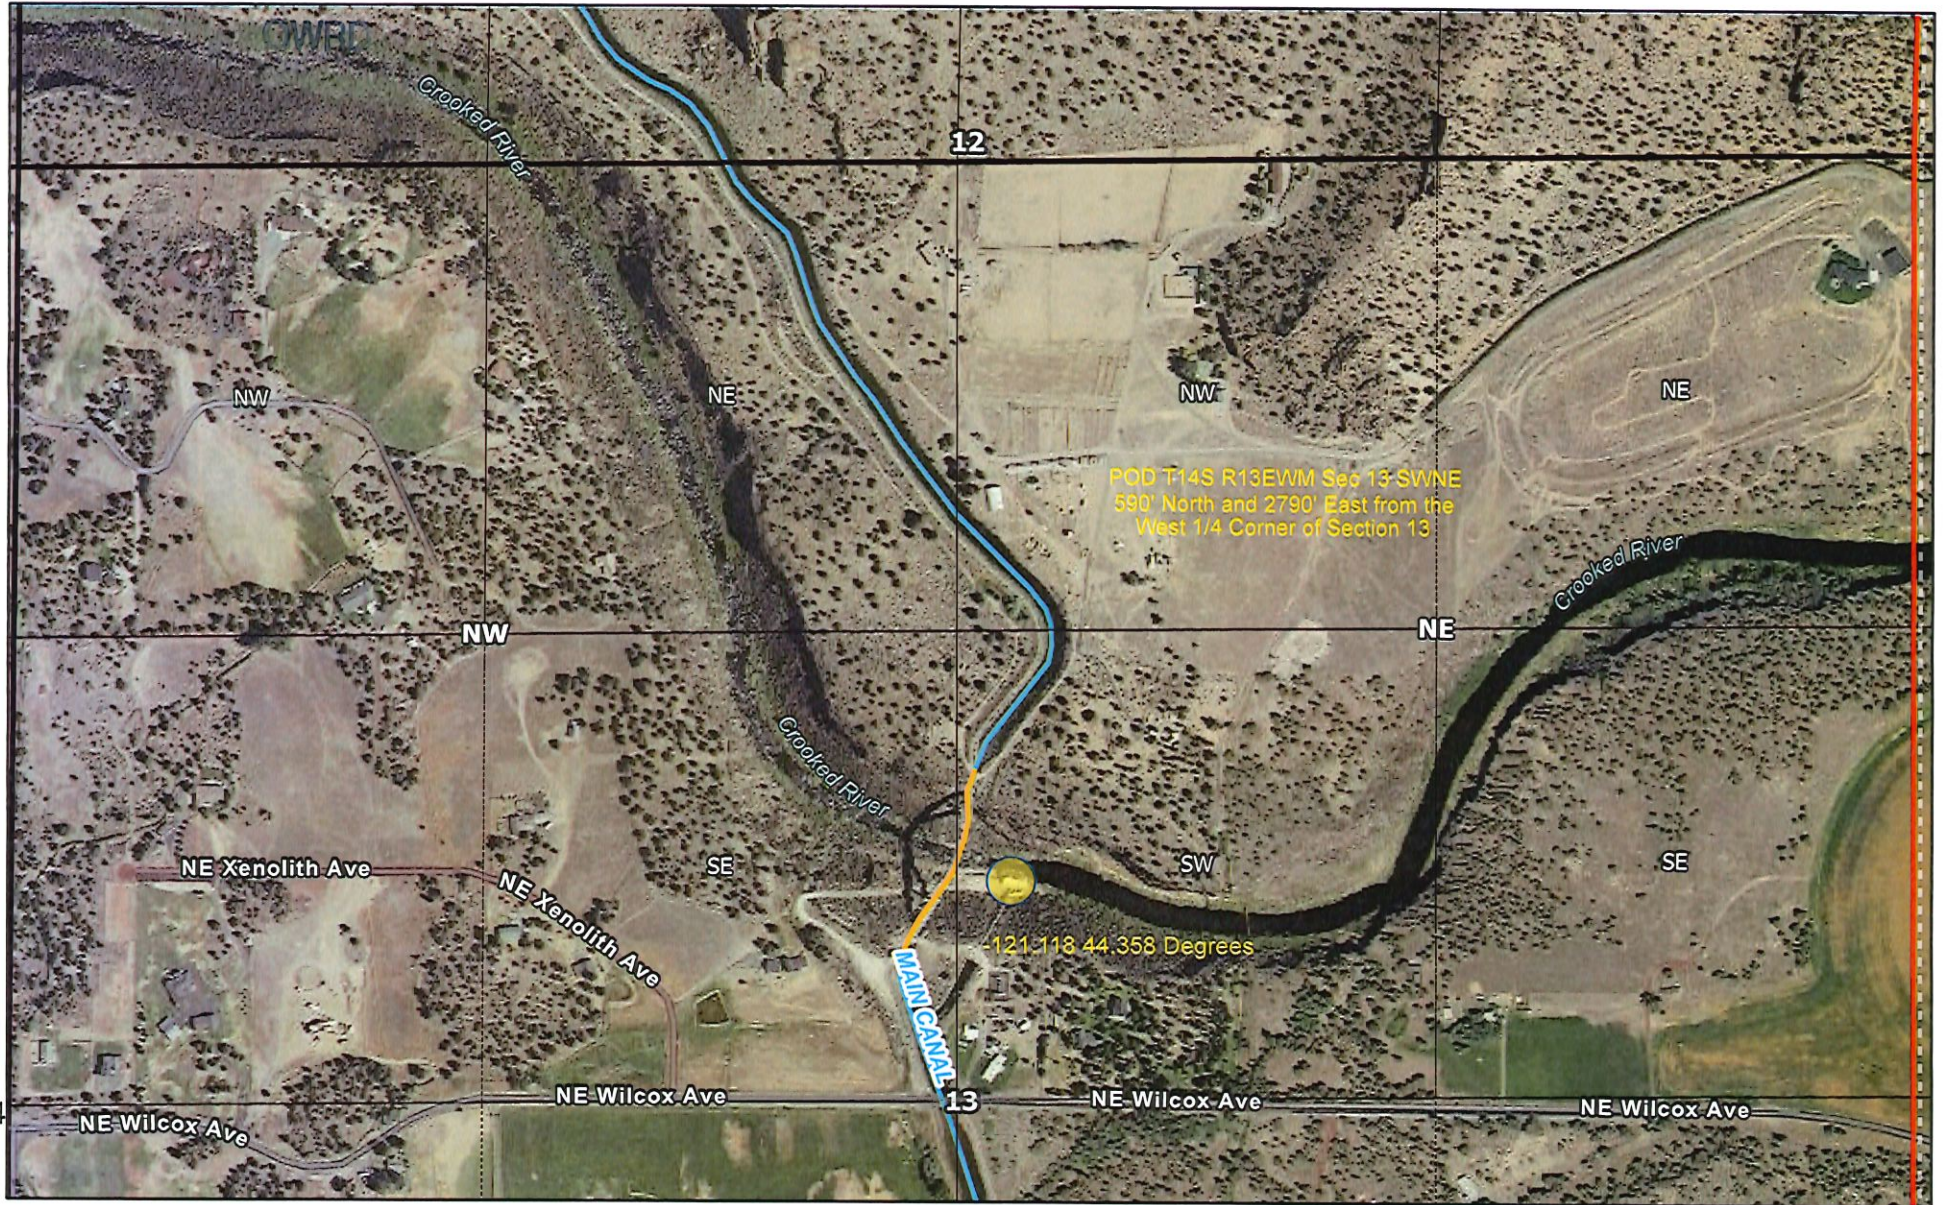

2/24/2022, 9:20:03 AM

- Override 1 POD
- Sections
- QuarterQuarters
- Pipeline
- TownshipRange
- QuarterSections
- Canals

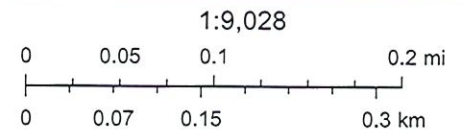

Esri Community Maps Contributors, State of Oregon GEO, ©

North Unit Irrigation District  
Copyright North Unit Irrigation District. All Rights Reserved.

LL-2024


THIS MAP IS PREPARED FOR ASSESSMENT PURPOSE ONLY

1014489

SECTION 13 T.14S. R.13E. W.M.  
DESCHUTES COUNTY

1" = 400'

14 13 13  
& INDEX

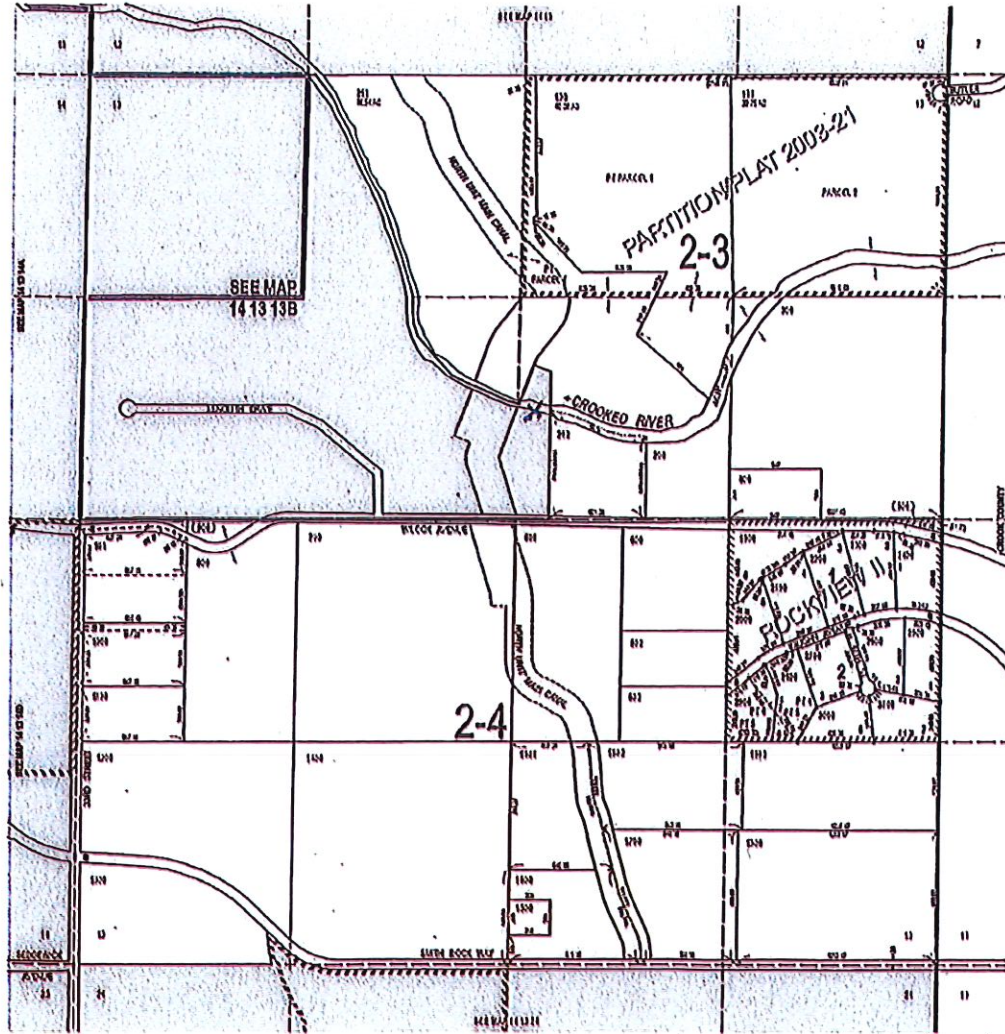

14 13 13  
& INDEX

POD T14S R13EWM X - P00  
Sec 13 SWNE  
590' North and  
2790' East from  
the West 1/4 Corner  
of Section 13

Received  
MAR 25 2026

OWRD

LL-2024