


CLAIM OF BENEFICIAL USE MAP
T-13665

LOCATED IN THE N 1/2 OF THE NE 1/4 OF SECTION 31, TOWNSHIP 15
SOUTH, RANGE 11 EAST, W.M., DESCHUTES COUNTY, OREGON

Received by OWRD
MAR 30 2026
Salem, OR

LEGEND

- TAX LOT CONTAINING WATER RIGHT OUTLINE
- ADJACENT TAXLOT
- QUARTER-QUARTER OUTLINE
- SECTION OUTLINE
- 800 TAX LOT CONTAINING WATER RIGHT NUMBER
- 700 ADJACENT TAX LOT
- S31 SECTION NUMBER
- NE 1/4 NE 1/4 QUARTER QUARTER
-  WELL - POD 1 - A WELL > DEEP CANYON (80' SOUTH, 2290' WEST FROM NE COR OF SECITON31)
-  T-13665 - IRRIGATED AREA 35.1 AC
- IRR--- 6" PVC PIPELINE TO PIVOT

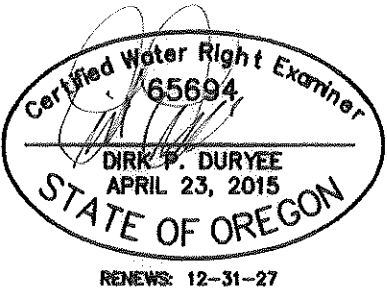


I, DIRK P. DURYEE, CERTIFIED WATER RIGHT EXAMINER IN THE
STATE OF OREGON, HEREBY CERTIFY THIS CLAIM OF BENEFICIAL
USE MAP WAS PREPARED UNDER MY DIRECT SUPERVISION.

THE PREPARATION OF THIS MAP IS FOR THE PURPOSE OF
IDENTIFYING THE LOCATION OF THE WATER RIGHT ONLY AND
HAS NO INTENT TO PROVIDE DIMENSIONS OR LOCATIONS OF
PROPERTY OWNERSHIP LINES.

2632 - Steiner Water Rights.dwg



TITLE: 2632 - STEINER WATER RIGHTS	
JOB NO: 2632 - BOTUG COBU	
SCALE: 1"=400'	DRAWN BY: P.A.T.
FIELD BOOK NO:	DATE: 02-04-2026
DWG NAME:	SHEET: 1 OF 1

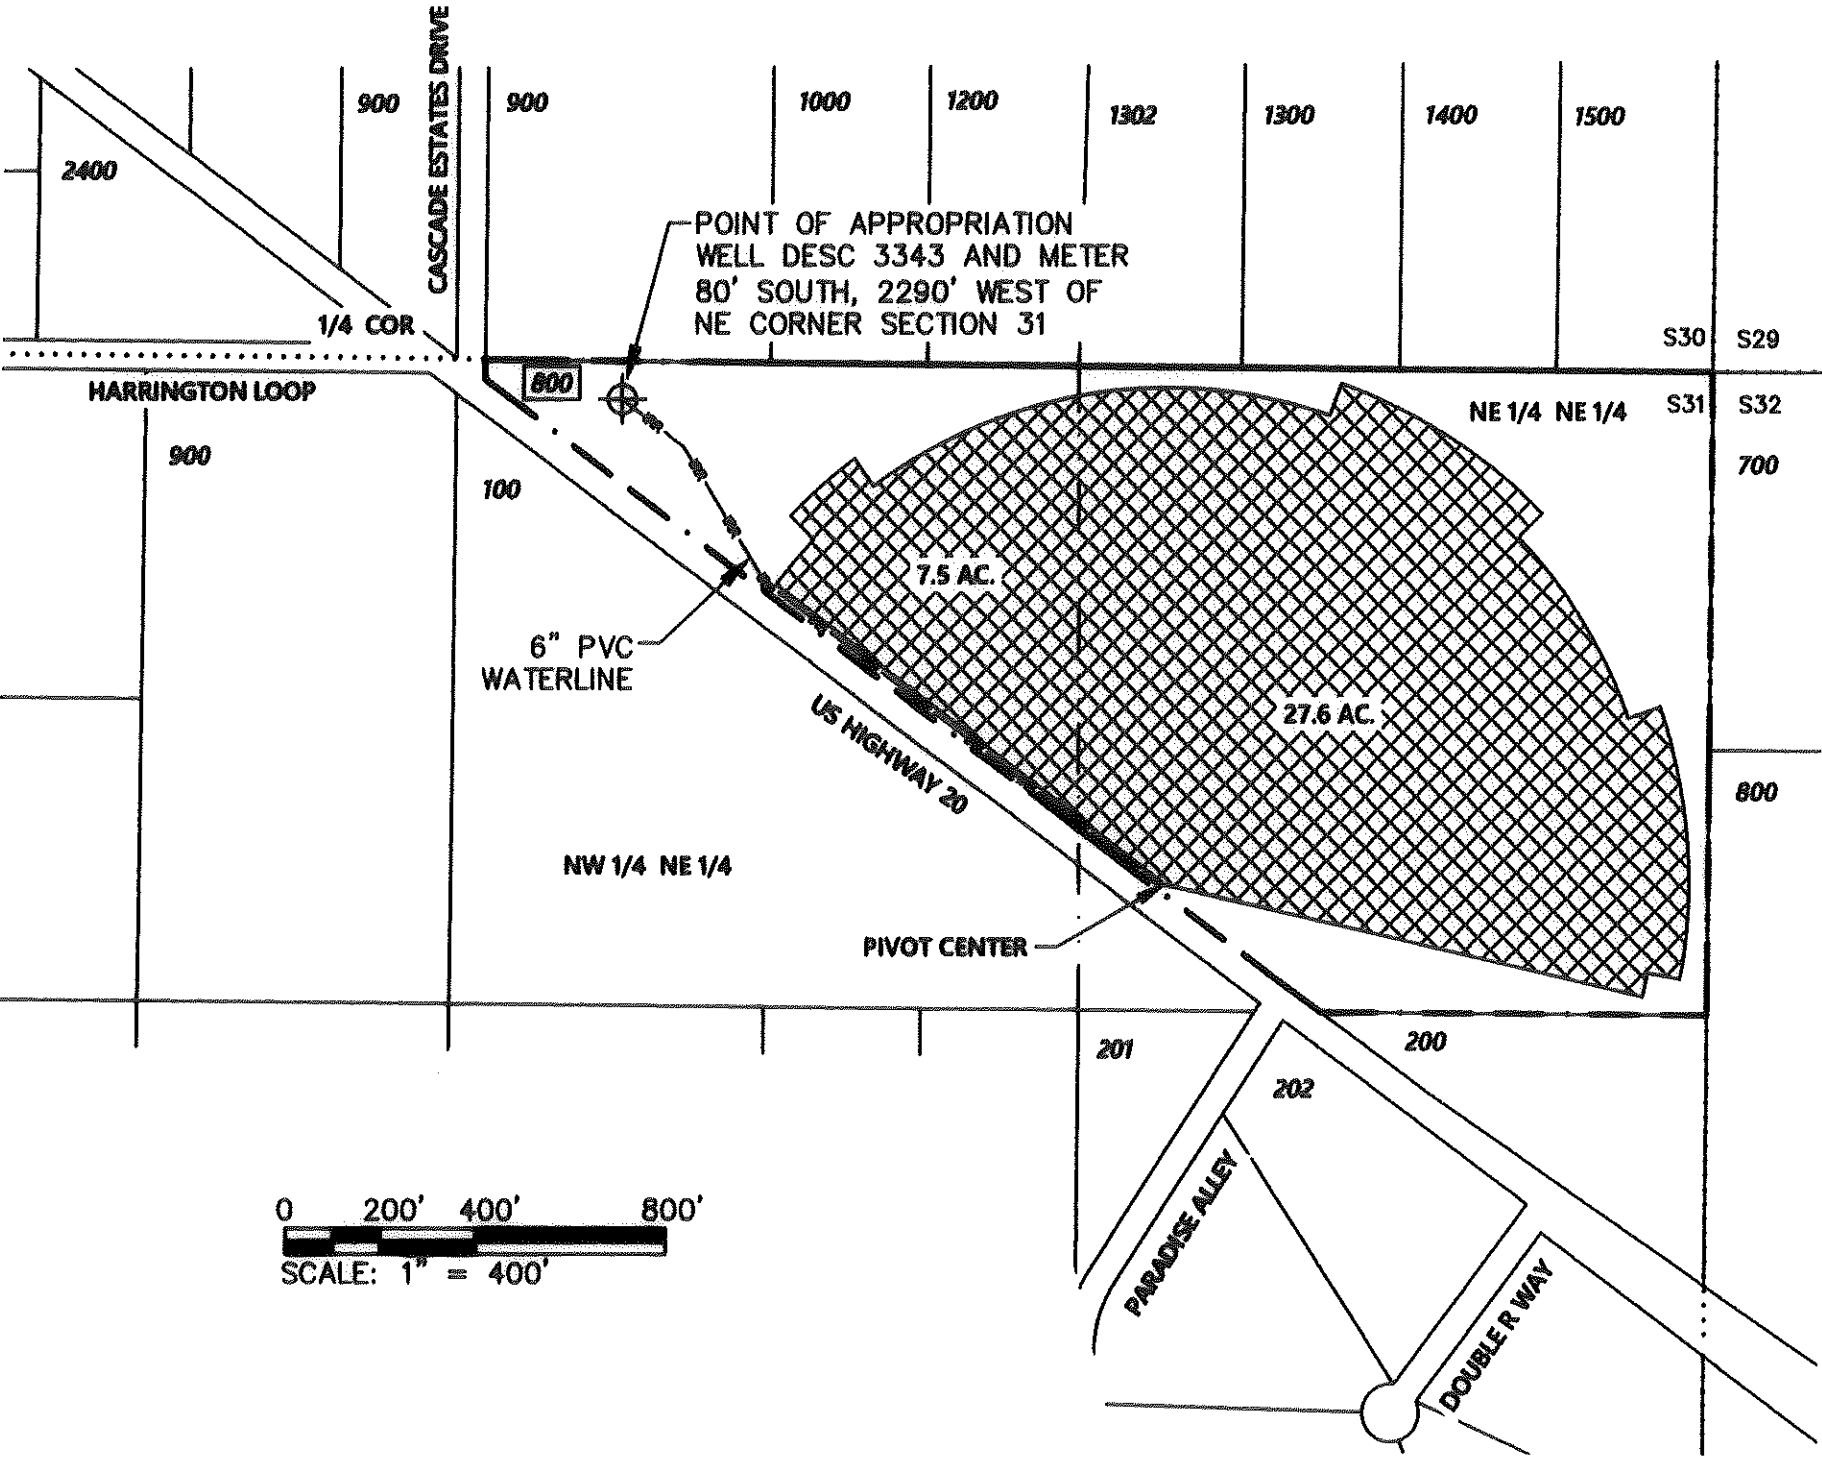

COBU MAP # 2185