
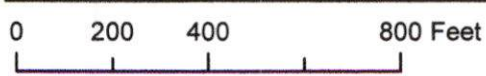


# Claim of Beneficial Use - Firestone

## Application R-86577, Permit R-14297

Township 6S, Range 5W, W.M.

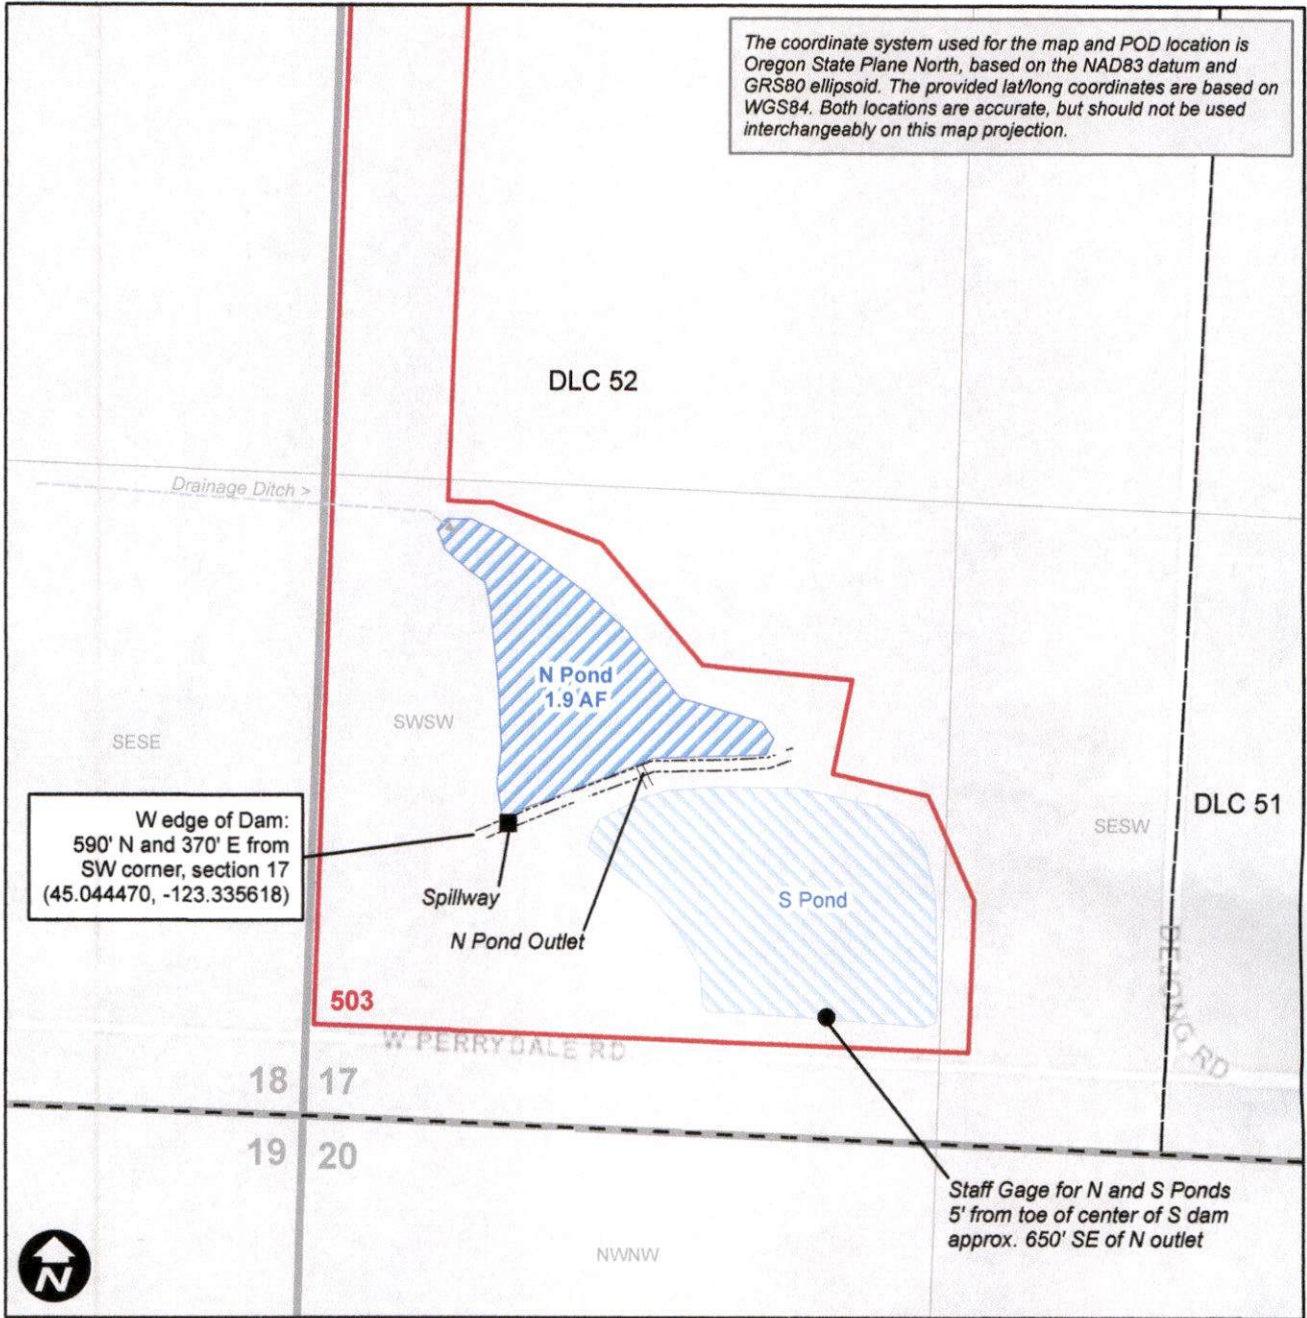

This map is not intended to provide legal dimensions or locations of property ownership lines.

- Legend**
- N Pond - POU
  - Taxlot
  - Dam
  - DLC



Received by OWRD  
 APR 08 2026  
 Salem, OR

EXPIRES: 12-31-2026