
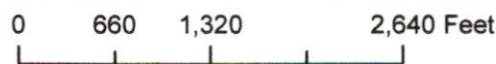


Claim of Beneficial Use - Firestone/Arrimeier Properties Application S-87129, Permit S-54467

Township 6S, Range 5W, W.M.

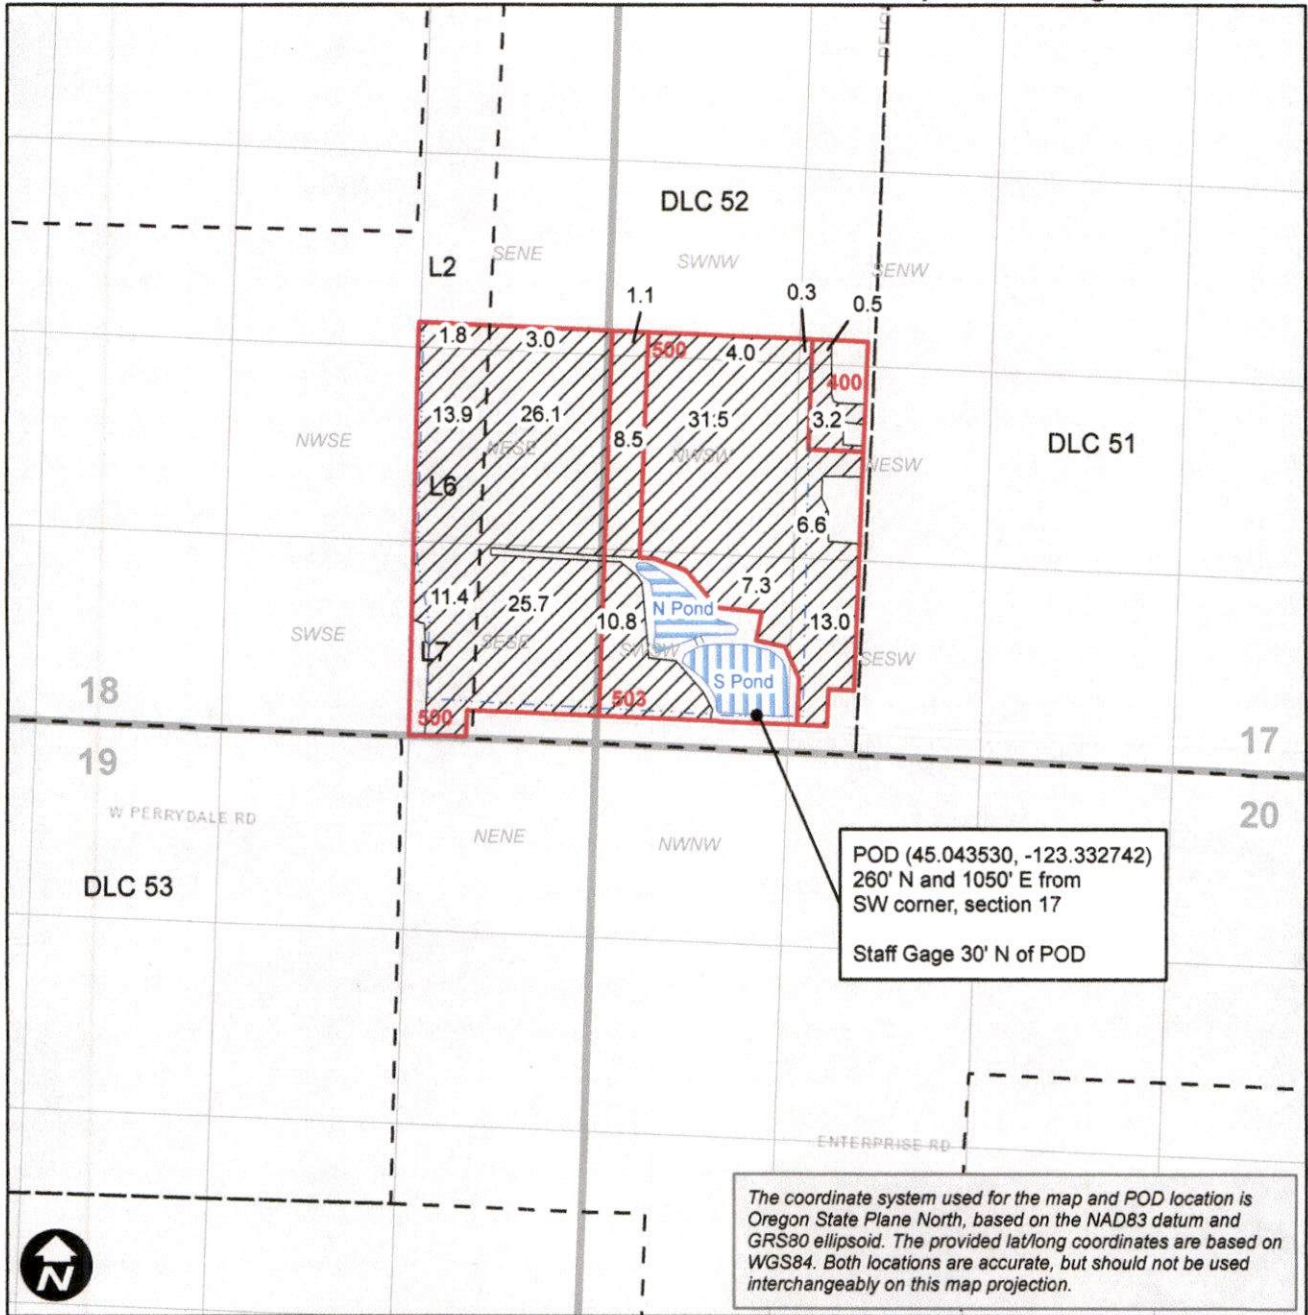

This map is not intended to provide legal dimensions or locations of property ownership lines.

- Legend**
- IR POU
 - DLC
 - Taxlot
 - Mainline

Received by OWRD
 APR 08 2026
 Salem, OR

