



SWNE

SWNW

NWSE




19
NWSW

SWSE

SESE

WSW

Received by OWRD
APR 08 2026
Salem, OR

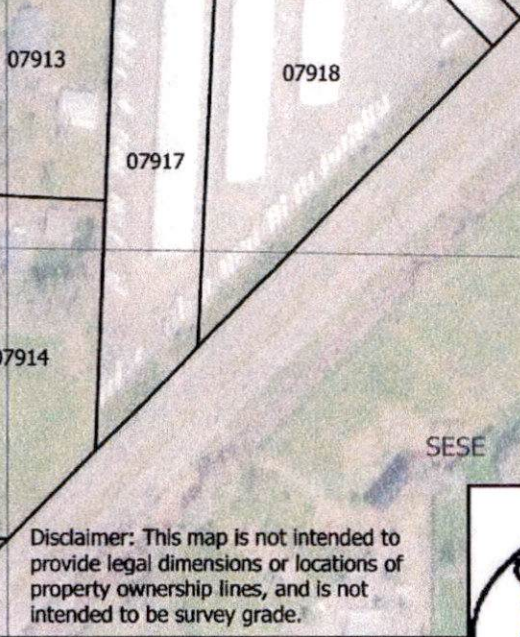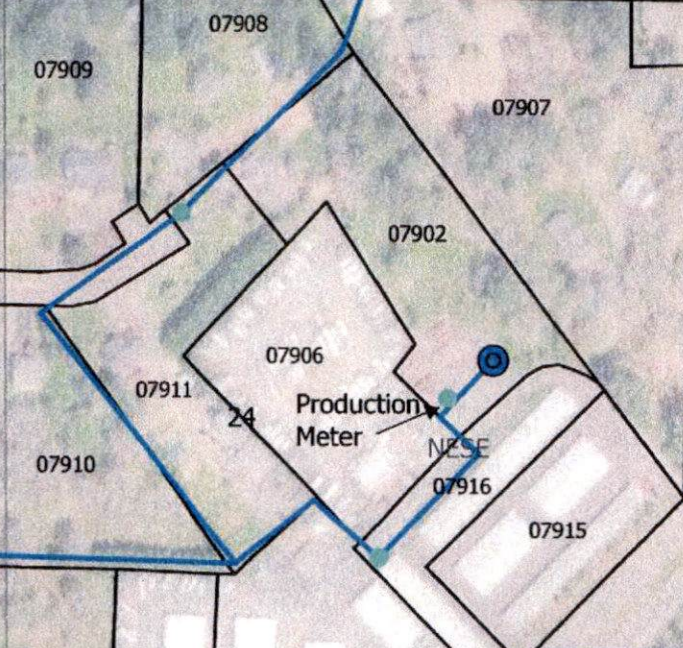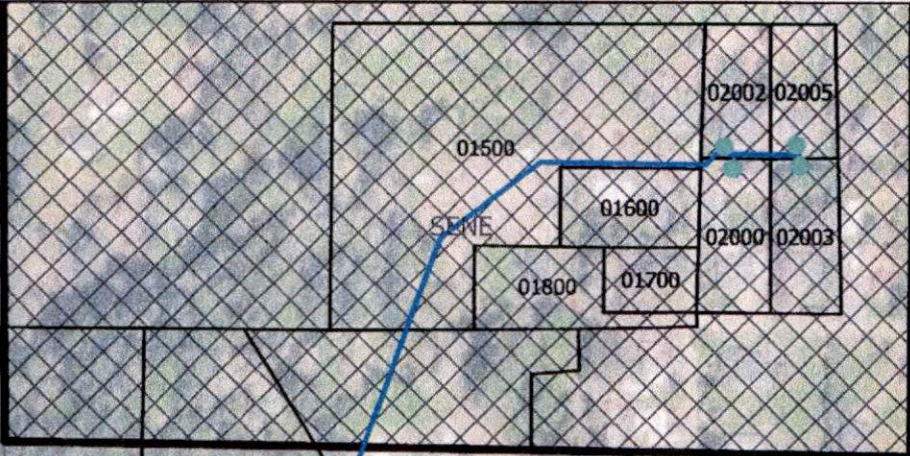

Legend

- Well 1 (45.29440012, -122.99367992)
- Meters
- Waterlines
- Taxlots
- Quarter Quarter
- Permit Area
- Sections

Disclaimer: This map is not intended to provide legal dimensions or locations of property ownership lines, and is not intended to be survey grade.

N
Scale 1"=400'
0 100 200 300 400 Feet
POU: Township 3S Range 3W W.M. Sect 24 SE NE
POA: Well 1: NE1/4SE1/4 S24 T3S, R3W W.M.
2136 ft. N & 664 ft W from SE corner, Sect 24

COBU Map

**Application G-16645
Permit G-16260**

CERTIFIED WATER RIGHT EXAMINER
89834CWRE
Natalie Jennings
NATALIE CAMPBELL JENNINGS
JUNE 03, 2016
STATE OF OREGON
RENEWS: 6/30/27