










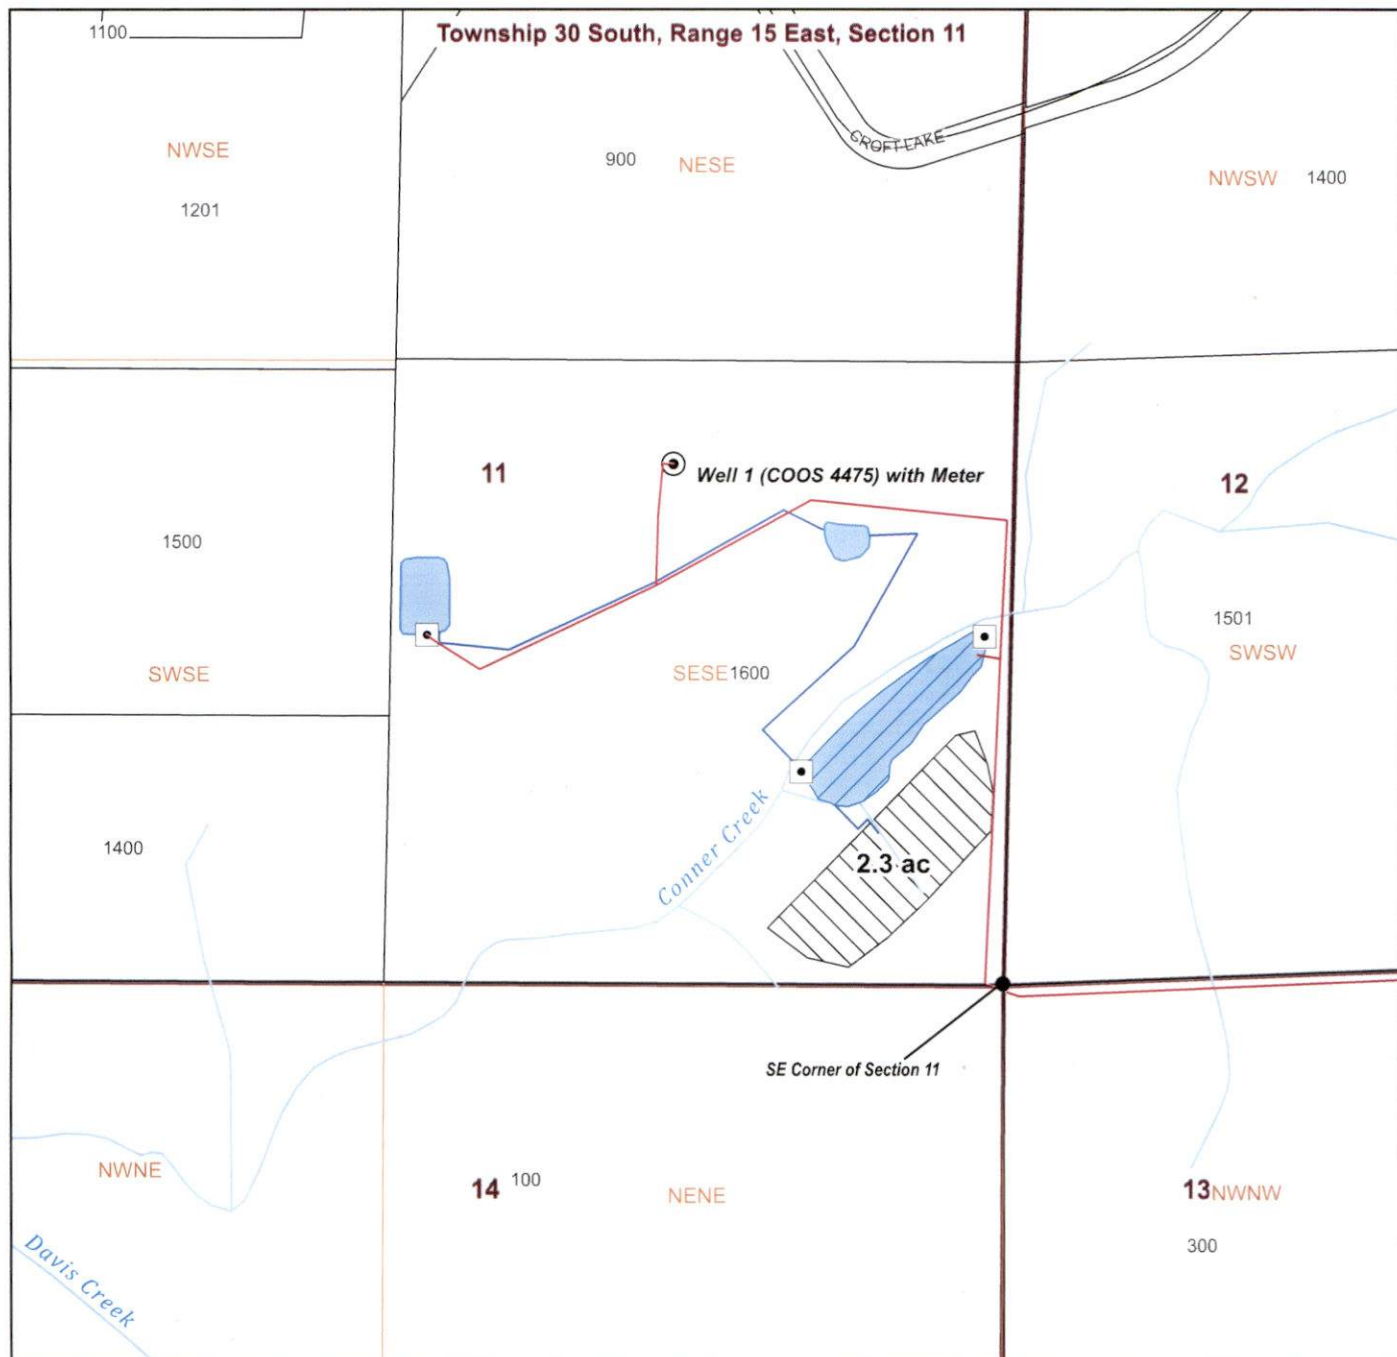

Claim of Beneficial Use Transfer T-9005

A Water Right held by Tony and Stephanie Arriola
Coos County



LEGEND

-  Point of Appropriation (POA)
-  Place of Use (POU), 2.3 ac CR
-  Well Supply Mainlines
-  Irrigation Mainline
-  Water System Pump
-  Bulge
-  Bulge and Reservoir (Certificate 72449)
-  Roads
-  Tax Lots
-  Watercourse

POA Location Description

Well 1 (COOS 4475)
 Located 1,100 feet North and 660 feet West from SE corner of Section 11, Township 30 South, Range 15 East (SESE), W.M. (42.98593800, -124.43884841, WSG84)

Received
APR 13 2026

OWRD

Date: 4/5/2026
 Data Sources: BLM, OWRD, USGS, Coos County.
 Project CRS: EPSG 32127 - NAD 32 / Oregon South
 Disclaimer: This map is not intended to provide legal dimensions or property ownership lines.

