

Request for Assignment



Oregon Water Resources Department
 725 Summer Street NE, Suite A
 Salem, Oregon 97301-1266
 (503) 986-0900
www.oregon.gov/owrd

If the Department determines that the application is incomplete, fees have not been paid, or the required documents are not acceptable, the application and all fees submitted will be returned to the applicant.
 If for multiple rights, a separate form and fee for each right will be required.

I, Roy & Leslie Walker
 (Name of Current Holder of Record)
515 River Bend Rd., Roseburg OR 97471 541-620-4783
 (Mailing Address) (City) (State) (Zip) (Phone #)
roy.firewalker13@gmail.com
 (Email Address)

- hereby assign all my interest in and to the entire application/permit/transfer order/limited license/groundwater statement; (Example, sold all the land authorized under the right)
- hereby assign all my interest in and to a portion of application/permit/transfer order/limited license/groundwater statement; (*You must include a map showing the portion of the application/permit/transfer order/limited license/groundwater statement to be assigned.* Example, sold a portion of the land authorized under the right)
- hereby assign a portion of my interest in and to the entire application/permit/transfer order/limited license/groundwater statement; (Example, adding an additional person)

Application # T-14380; Permit # _____; Transfer Order # _____;
 Limited License # _____; Groundwater Statement # _____;

Received
APR 15 2026
OWRD

as filed in the office of the Water Resources Director, to:

Cody & Ember Conner
 (Name of New Owner)
26272 Pine Creek Rd., John Day OR 97845 541-620-4560
 (Mailing Address) (City) (State) (Zip) (Phone #)
ember.conner@gmail.com
 (Email Address)

Note: If there are other owners of the property described in the application, permit, transfer order, limited license, or groundwater statement, you must provide a list of all other owners' names and mailing addresses and attach it to this form. Write the initials (first letters) of your first and last names at the spot indicated below.

X I hereby certify that I have notified all other owners of the property described in this application, permit, transfer order, limited license, or groundwater statement of this Request of Assignment.

Witness my hand this 12th day of April, 2026.
 (Day) (Month) (Year)

Signature of Current Holder of Record Roy L. Walker, Leslie A. Walker

Failure to provide any of the required information will result in the return of your application.


Part. Assign - Approve
 WSD 4-16-2026

This certifies assignment and record change at Oregon Water Resources Department effective 8:00 a.m. on date of receipt at Salem, Oregon.

Fee receipt # 147160
 For Director by Mary F. Bjork, Program Analyst in Water Rights Division. MFB

The completed "Request for Assignment" form *must* be submitted to the Department along with the recording fee of \$180.

SECTION 1, T.14S., R.32E., W.M.
GRANT COUNTY, OREGON
TRANSFER APPLICATION MAP
CHANGE IN POINT OF DIVERSION & ADDITIONAL POINT OF DIVERSION
FOR
ROY AND LESLIE WALKER, JAMES AND MARY JENSEN &
THE JAMES JERRY JENSEN AND MARY S. ALEXANDER TRUSTS

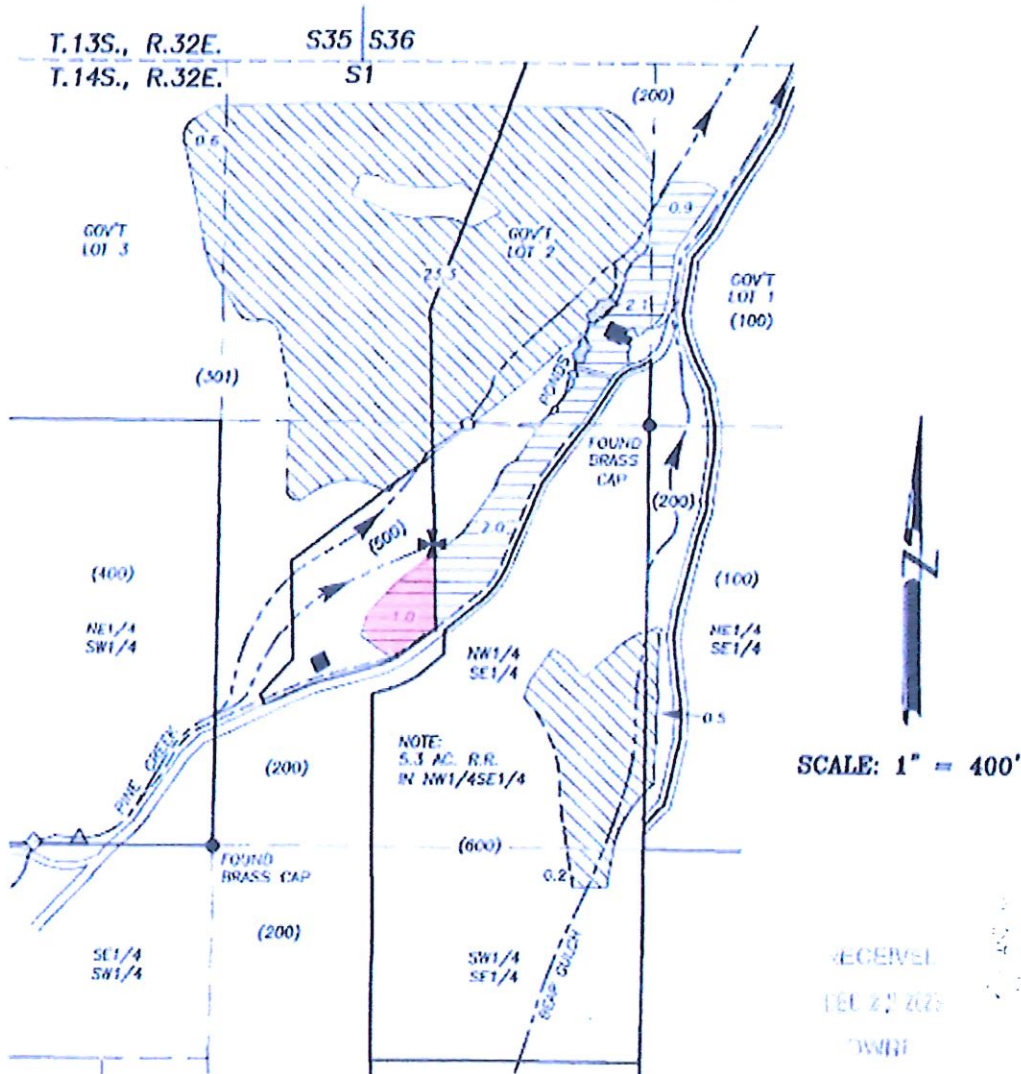

- ◇ AUTHORIZED POD #1: LOCATED IN THE NE1/4SW1/4 SEC. 1, T.14S., R.32E., W.M. PER ADJUDICATION MAP
- △ PROPOSED POD #2: 23 FT. NORTH & 416 FT. WEST FROM THE S.E. COR. OF THE NE1/4SW1/4 SEC. 1, T.14S., R.32E., W.M.
- PROPOSED APOD #3: 1 FT. SOUTH & 560 FT. WEST FROM THE S.E. COR. GOVT LOT 2, SEC. 1, T.14S., R.32E., W.M.
- ✦ PROPOSED FLOOD CHANNEL BLOCK - APPROXIMATE LOCATION
- PLACE OF USE: C-25974
- ▨ REMAINING RIGHT: C-25974
- DITCH
- () TAX LOT NO.

PREPARED BY:
ROBERT D. BAGETT, PLS, CWRE
 217 N. CANYON BLVD.
 JOHN DAY, OREGON
 (541) 575-1251
 NOVEMBER 7, 2023



14380 -

DISCLAIMER: THIS MAP IS NOT INTENDED TO PROVIDE LEGAL DIMENSIONS OR LOCATIONS OF PROPERTY OWNERSHIP LINES

RENEWS 12/31/2025

Received
 APR 15 2026
 OWRD

RECEIVED
 FEB 27 2024
 TWINT