


Claim of Beneficial Use - Transfer T-13040

Montecucco Farms, LLC

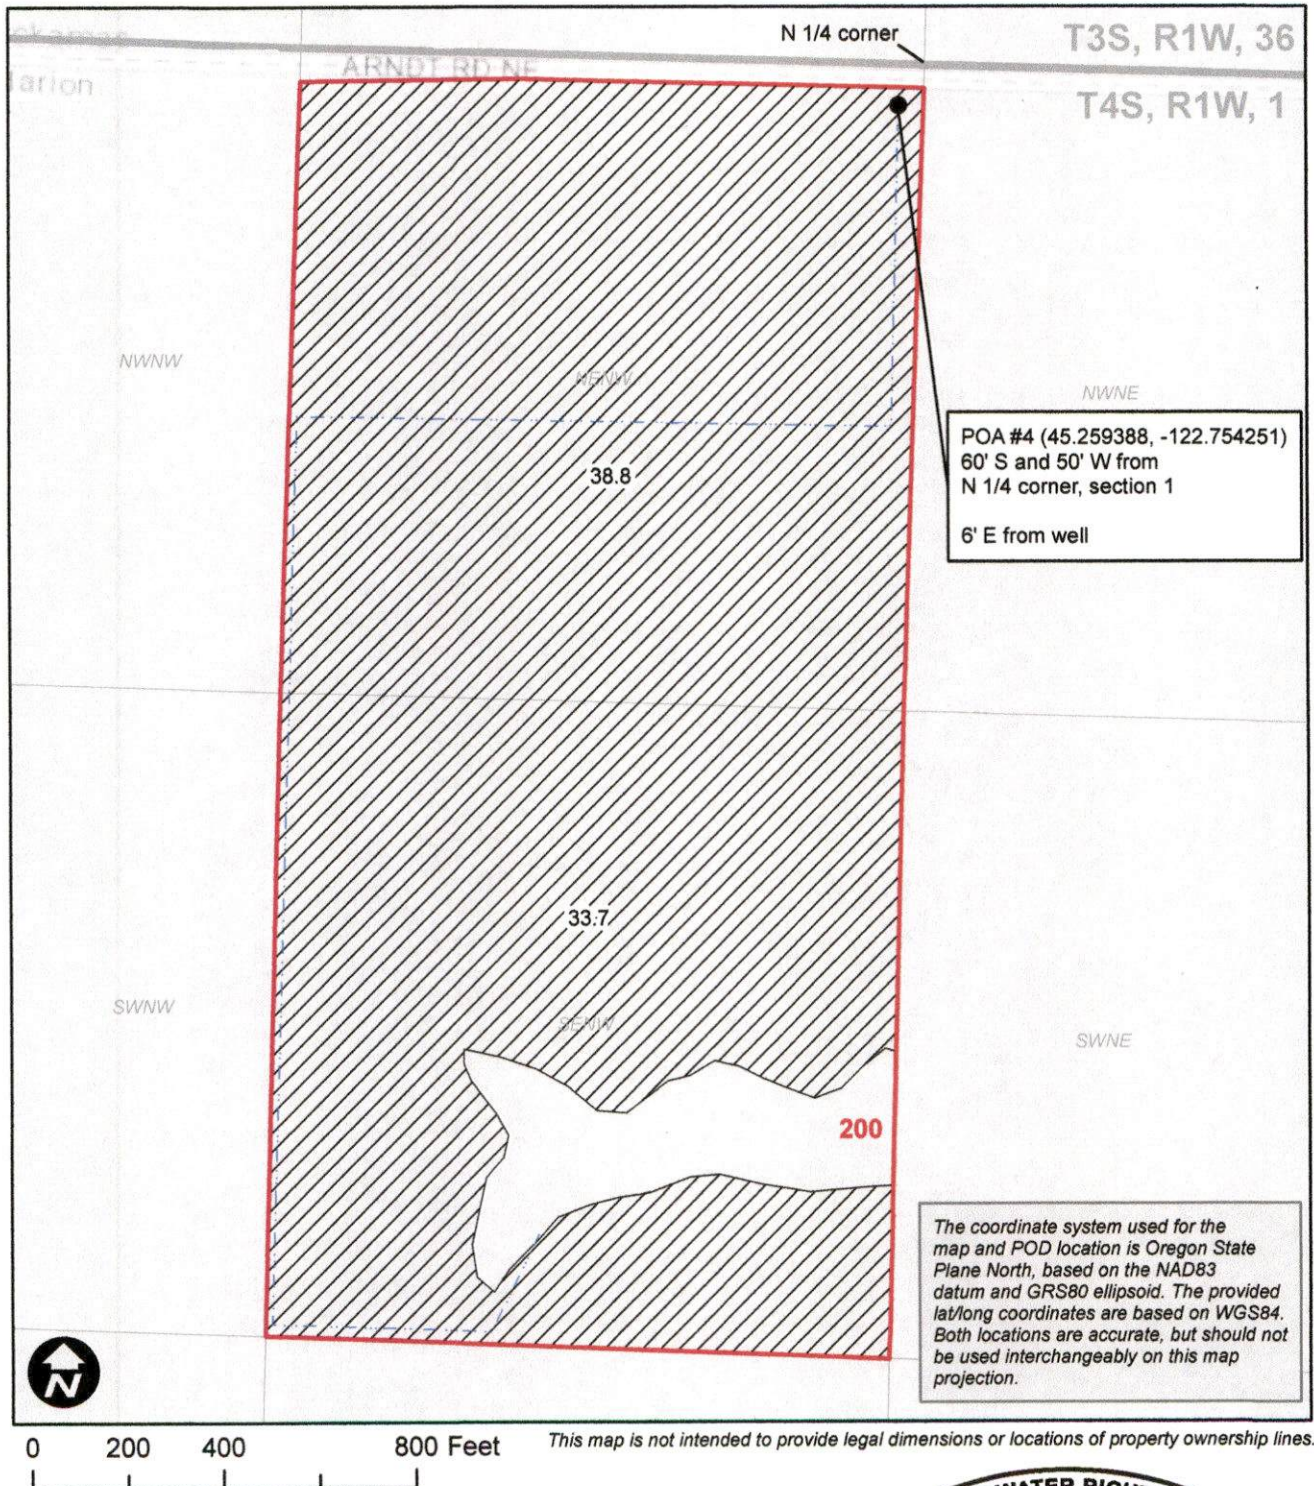

Legend

IR POU Mainline Taxlots

Received by OWRD

APR 22 2026

Salem, OR



EXPIRES: 12/31/2026