


APR 22 2026

Salem, OR

T.4S. R.1W. Sec. 2 & 11, W.M.

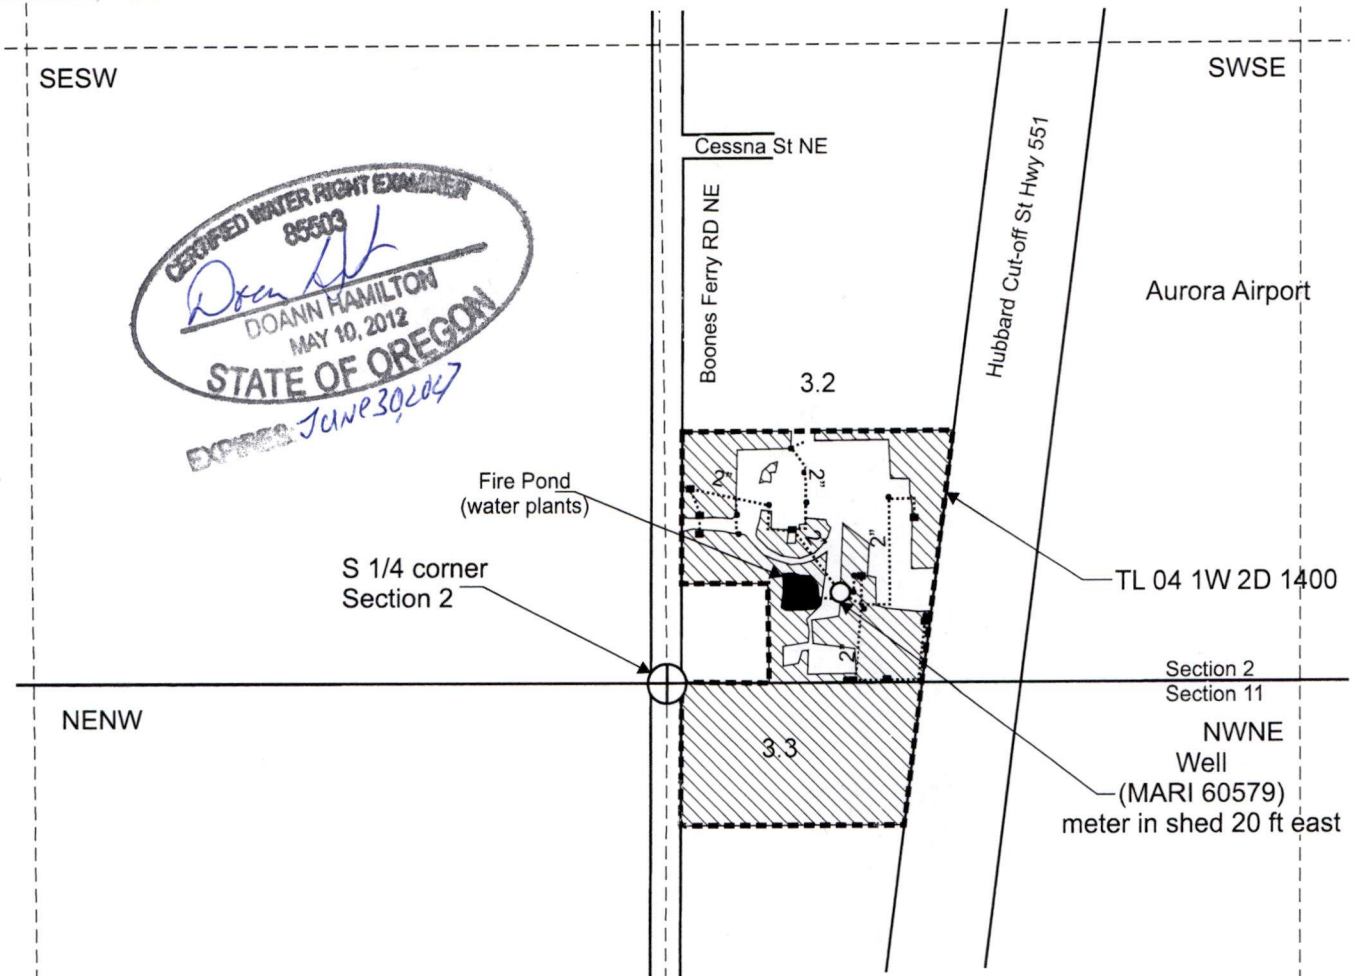

Well (MARI 60579) is located 190 feet north and 360 feet east from the S 1/4 corner, Section 2. (45.245619, -122.773097), WGS 84 datum.


Area (6.5 Acres) of nursery use under Application G-16557, Permit G-16073

----- Tax lot boundary

..... Water main line

- Frost Free Faucets
- Valve Boxes

Scale: 1" = 400'

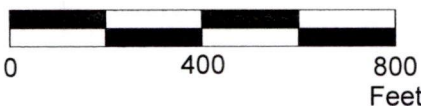

This map was prepared for the purpose of identifying the location of a water right only and is not intended to provide legal dimensions or location of property ownership lines.

Claim of Beneficial Use Map
Application G-16557, Permit G-16073

WILL MCGILL SURVEYING LLC

04/2026

Bullfrog Properties LLC
T.4S. R.1W. Sec. 2 & 11, W.M.