

● POD 2 & Fish Screen

▣ Cistern & Meter

----- Creek

----- Pipeline

▨ POU - Domestic Use


— Section

----- Quarter Quarter

□ Tax Lot




**T34S R1E, WM,
JACKSON COUNTY, OR**

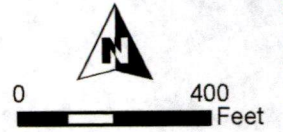

1" = 400'

Domestic Use (House) Coordinates:
Lat: 42.630066 Long: -122.674981 WGS84

POD 2 Location:
180' N, 930' W of W 1/4 Cor Sec 11
Lat: 42.629907 Long: -122.675989 WGS84

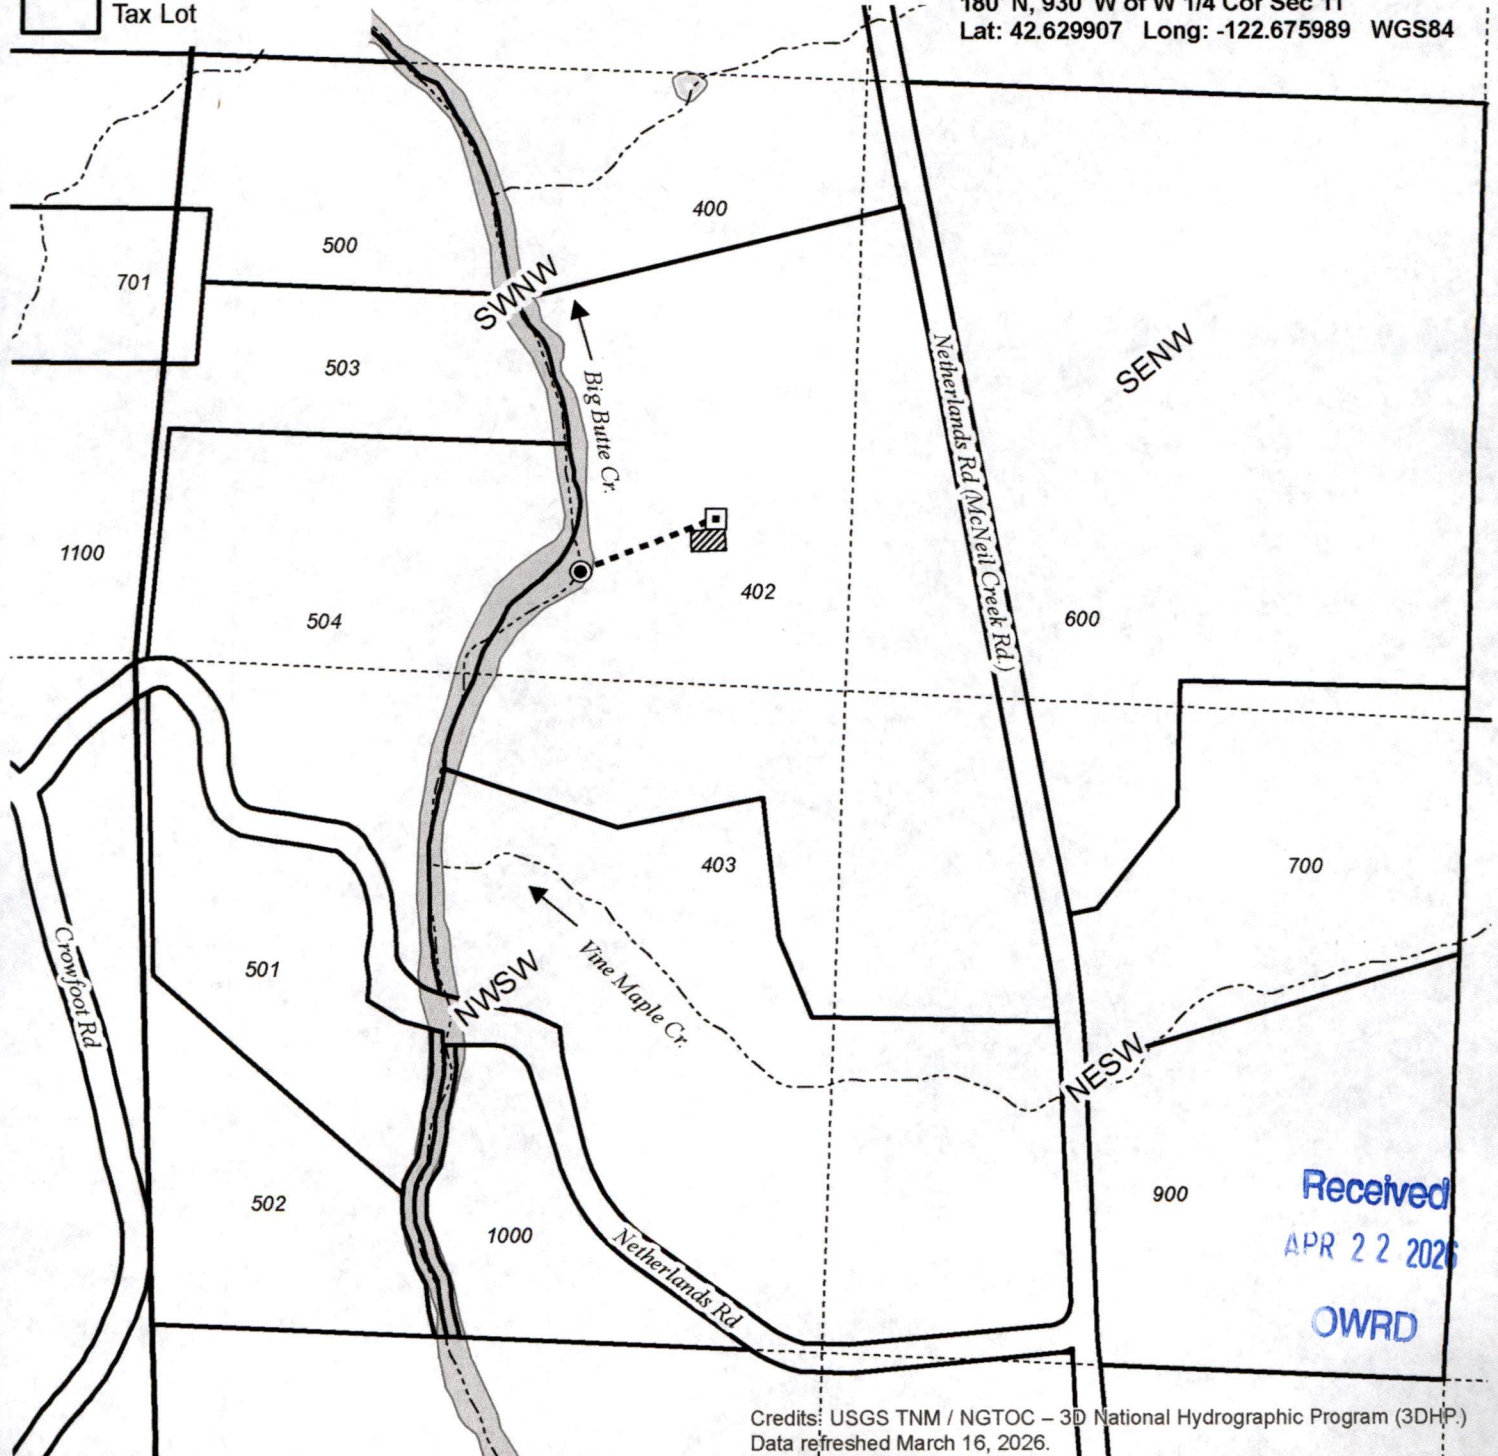

Credits: USGS TNM / NGTOC - 3D National Hydrographic Program (3DHP).
Data refreshed March 16, 2026.

CLAIM OF BENEFICIAL USE MAP
David Davern

Date: 4/4/2026

T-14019

This map is not intended
to provide legal dimensions
or locations of property
ownership lines.

WATER RIGHT SERVICES, LLC
PO BOX 1830, BEND, OR 97709
WWW.OREGONWATER.US
info@oregonwater.us 541-389-2837