


- LEGEND**
- ⊙ Authorized Point of Appropriation (POA)
  - M Meter
  - S Storage Tanks (10,000 Gallons x 4)
  - Conveyance Line
  - ▨ Authorized Place of Use (POU)

- All Other Features**
- Major Road
  - ~ Watercourse
  - Waterbody

**Claim of Beneficial Use Map**  
**ABG Oregon Vineyards, LLC**  
**Application G-18997; Permit G-18552**

**Yamhill County**  
 Township 2 South, Range 4 West (W.M.)

**CERTIFIED WATER RIGHTS EXAMINER STAMP**

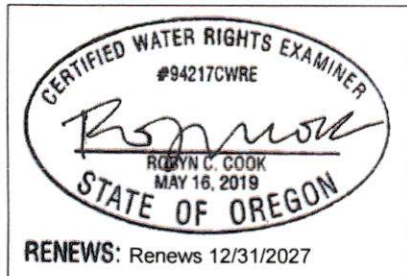

**LOCATION DESCRIPTION**

- Well 1**  
 Located 1595 feet North and 1300 feet East from the SW corner of Section 35, Township 2 South, Range 4 West (W.M.) (45.350855, -123.148945)
- Well 2**  
 Located 1210 feet North and 960 feet East from the SW corner of Section 35, Township 2 South, Range 4 West (W.M.) (45.349817, -123.150283)
- Well 3**  
 Located 1820 feet North and 1600 feet East from the SW corner of Section 35, Township 2 South, Range 4 West (W.M.) (45.351469, -123.147788)
- Well 5**  
 Located 1435 feet North and 1180 feet East from the SW corner of Section 35, Township 2 South, Range 4 West (W.M.) (45.350393, -123.149421)

Received

APR 27 2026

OWRD

**DISCLAIMER**  
 This map was prepared for the purpose of identifying the location of a water right only and it is not intended to provide legal dimensions or location of property ownership lines.

Date: April 3, 2026  
 Data Sources: BLM, ESRI, OWRD, USGS  
 Datum: NAD83 (2011)

