

32 33 T2N R17E
5 4 T1N R17E


T1N R17E, WM,
SHERMAN COUNTY, OR

Received
MAY 07 2026
OWRD

Scott Canyon Rd

L4
(NWNW)

L3
(NENW)

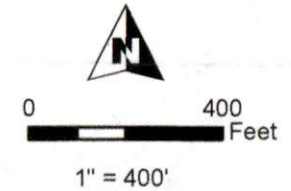


- Well & Meter
- Pipeline
-  POU Irrigation
- Township
- Section
- Quarter Quarter
- Tax Lot

Well (SHER 50175 / L-70770) Location:
1760' S, 40' E of NW Cor Sec 4
Lat: 45.601190 Long: -120.707658 WGS84



RENEWS: 06/30/2026

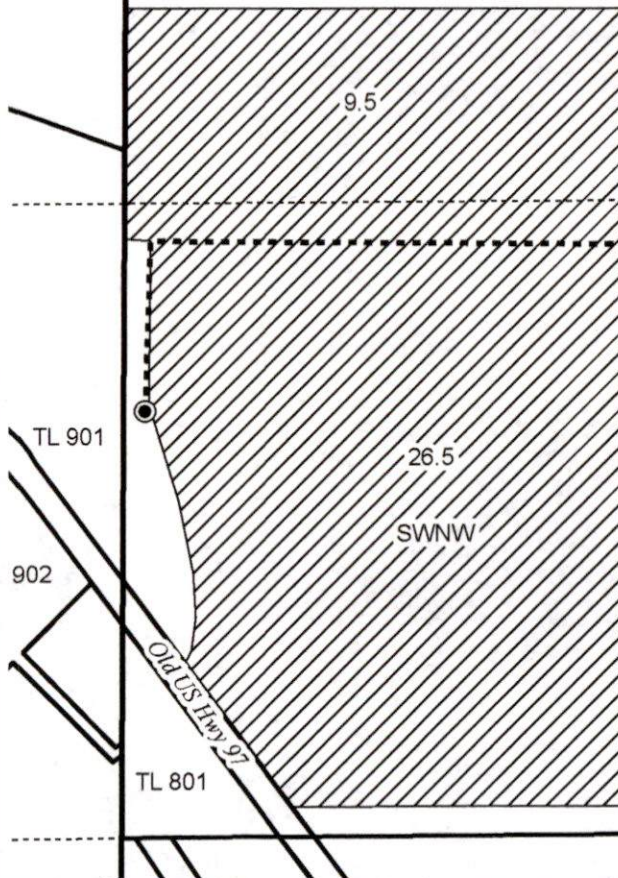

City of Wasco

SENW

**CLAIM OF BENEFICIAL USE MAP
BARNETT ESTATE**

Date: 4/6/2026 Ap G-16663 Permit G-16196

This map is not intended
to provide legal dimensions
or locations of property
ownership lines.

WATER RIGHT SERVICES, LLC

PO BOX 1830, BEND, OR 97709
WWW.OREGONWATER.US
info@oregonwater.us 541-389-2837