


Claim of Beneficial Use - Weyerhaeuser Co./Aurora Forest Nursery Transfer T-13181

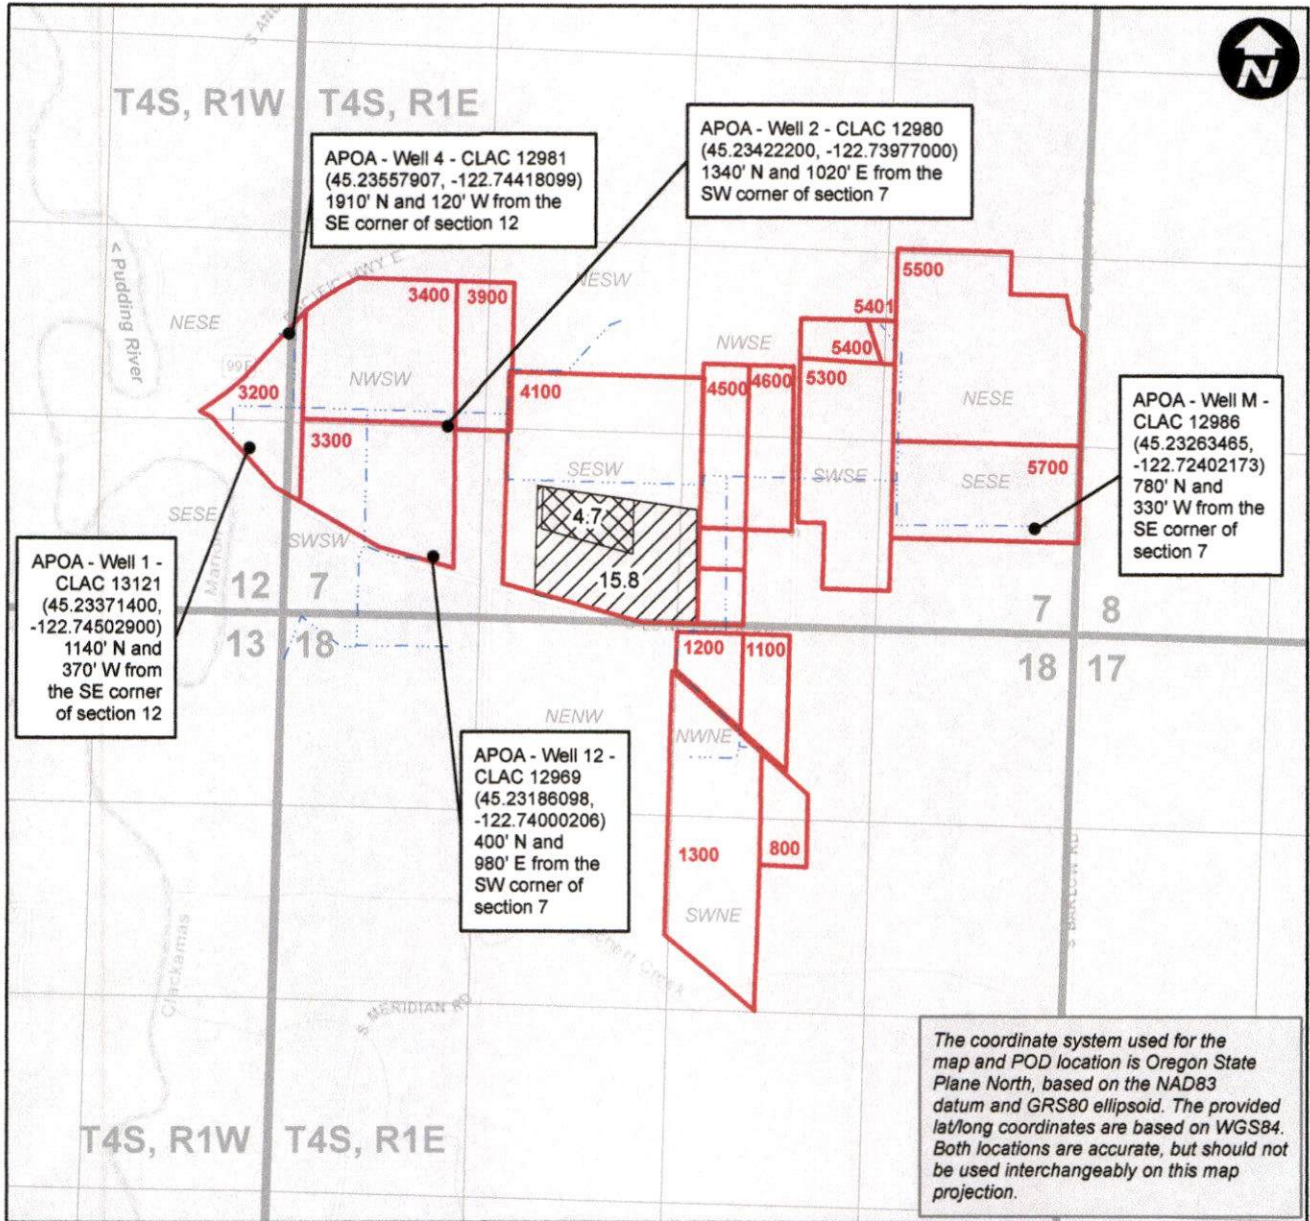

0 660 1,320 2,640 Feet

This map is not intended to provide legal dimensions or locations of property ownership lines.

Legend

-  POU (former Cert. 72472 IR/IS & Cert. 72754 FR)
-  POU (former Cert. 72754 FR)
-  Mainline
-  Taxlots

Received by OWRD
MAY 08 2026
Salem, OR

