






T.4S. R.1E. Section 28, W.M.

Gribble
DLC 41

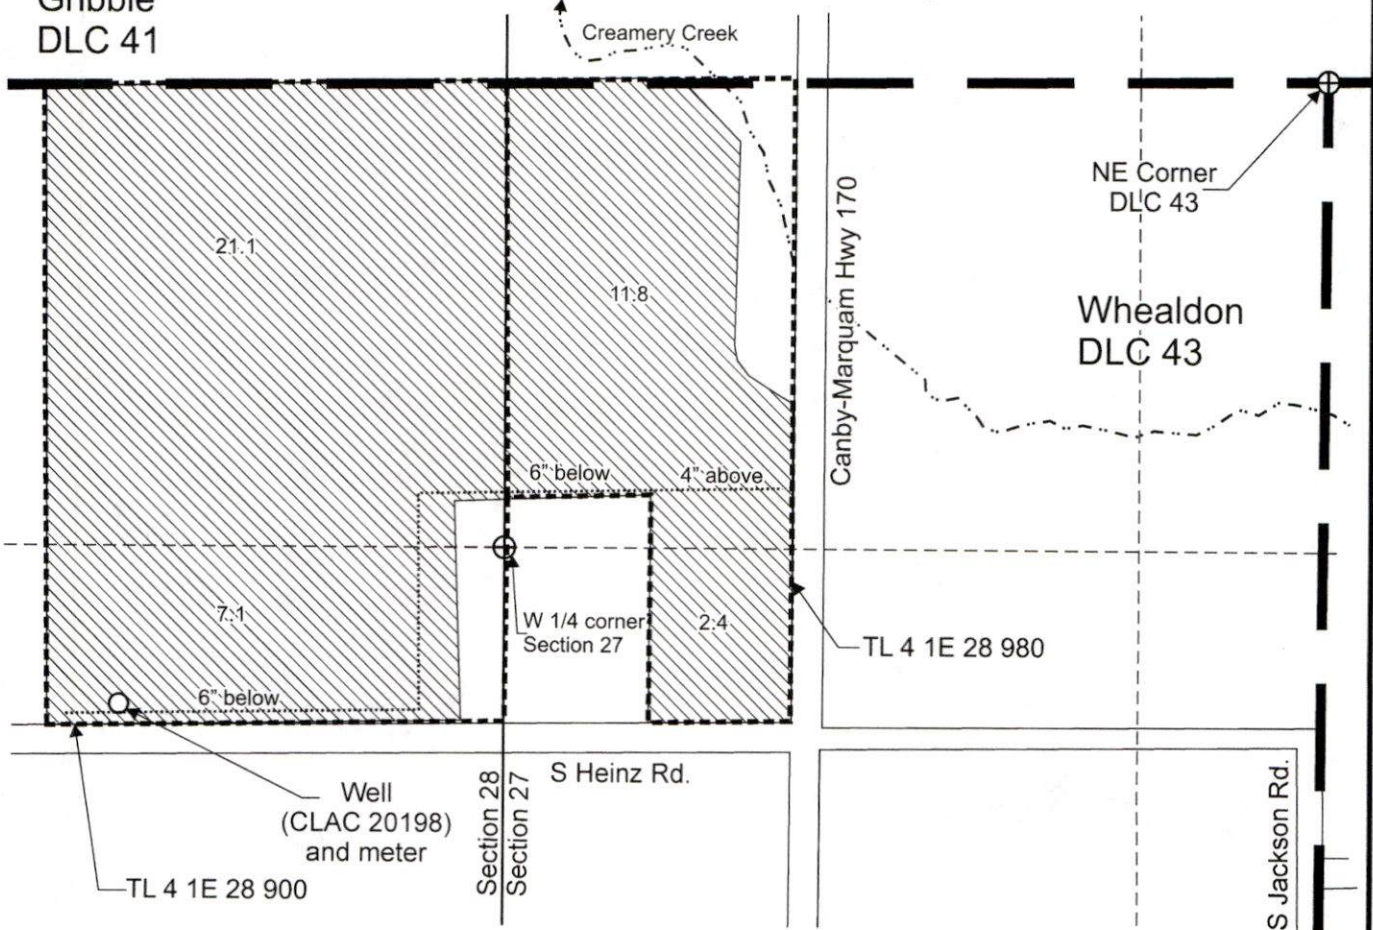


Well (CLAC 20198) is located 1,305 feet south and 2,510 feet west from the NE corner, DLC 43.

-  Area (42.4 Acres) irrigated under Application G-15177, Permit G-14987.
-  Tax lot boundary
-  Donation Land Claim Boundary
-  Irrigation mainline

RECEIVED


NOV 05 2015

WATER RESOURCES DEPT
SALEM, OREGON

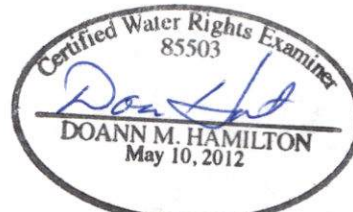

RENEWS June 30, 2017

Scale: 1" = 400'

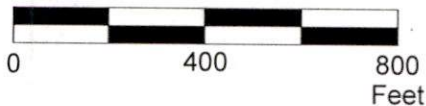

This map was prepared for the purpose of identifying the location of a water right only and is not intended to provide legal dimensions or location of property ownership lines.



Claim of Beneficial Use Map
Application G-15177, Permit G-14987

Daniel and Janet Hostetler
T.4S. R.1E. Section 28, W.M.

Pacific Hydro-Geology Inc.

10/2015

HostetlerCOBU.cdr