

Received

MAY 13 2026

OWRD

CLAIM OF BENEFICIAL USE MAP

T3S, R3W, SECTION 33, TAX LOTS 300, 315, 316, 318, 319, DLC 55, W.M.
APPLICATION G-18079; PERMIT G-17658
YAMHILL COUNTY

LABELS:

- A) WELL #7; PERMIT G-17658; APP G-18079
- B) WELL #1; CERTIFICATE 87851 & 87371; PERMIT G-11841
- C) WELL #2; CERTIFICATE 88371; PERMIT G-13896
- D) WELL #3; CERTIFICATE 88371; PERMIT G-13896
- E) WELL #4; CERTIFICATE 88371; PERMIT G-13896
- F) PUMP HOUSE WITH METERS FOR WELLS 2, 3, 4, QUARRY POND AND WELL#7.
- G) 4,000 GALLON UNDERGROUND TANK WITH 2 HP BOOSTER PUMP.
- H) 30,000 GALLON UNDERGROUND TANK WITH GRAVITY FEED TO WINERY.
- I) WINERY WITH BOOSTER PUMP SYSTEM (3 HP AND 5 HP) & COMMERCIAL USE.
- J) SHOP; CERTIFICATE 87843 & 87371; PERMIT G-11841; METERS FOR IRR. AND DOMESTIC.
- K) QUARRY POND; PERMIT R-14968; PERMIT S-54831

WELL#7 PLACE OF USE;
PERMIT G-17658; APP. G-18079

SEC	1/4 1/4	DLC	PRIMARY IRR.	DEFICIENCY IRR.	SUPPLEMENTAL IRR.
33	NE/NW	55	13.3	—	—
33	NW/NW	55	10.2	4.8	—
33	SW/NW	55	0.3	20.3	—
33	SE/NW	55	3.2	5.6	6.9
SUM (ACRES):			27.0	30.7	6.9



1 inch = 400 ft.
PRINT SCALE=11"x17"

LEGEND

IRRIGATION AREAS

NOTE: ALL HATCHED AREAS ARE FOR IRRIGATION FROM WELL #7.

30.7 ACRES PRIMARY DEFICIENCY
PRIMARY CERTIFICATES
#87851, #88371 & WELL #7
SUPP. PERMIT S-54831

6.9 ACRES SUPP. IRR.
PRIMARY PERMIT S-54831.
SUPP. PERMIT G-17658

27.0 ACRES PRIMARY IRR.
WELL #7
PRIMARY PERMIT G-17658


LINES AND SYMBOLS

- SECTION AND 1/4-1/4 LINES
- - - 4" DIA. PVC BURIED MAINS
- DLC LINE
- - - TAX LOT LINE
- - - DOMAINE SERENE / FOXGLOVE VINEYARD EXTERIOR PROPERTY LINES
- ⊙ WELL LOCATION
- ⊙ SECTION CORNER MONUMENT

OWNERS:
DOMAINE SERENE VINEYARDS AND WINERY, INC.
FOXGLOVE PROPERTIES, LLP
DEEPWATER C&D PROPERTIES, LLC
6555 NE HILLTOP LANE
DAYTON, OR 97114

POD	TWP	RNG	SEC	Q-Q	TL	DLC	MEASURED DISTANCE	LAT. / LONG.
WELL 7 PERMIT G-17658	3S	3W	33	NE NW	316	55	1074'S AND 1642'E FROM NW CORNER OF SECTION 33	LAT: 45.27059000 LONG: -123.06678000

NOTE: THIS MAP IS PRODUCED TO APPLY FOR THE BENEFICIAL
USE OF A WATER RIGHT. IT IS NOT INTENDED TO PROVIDE
INFORMATION RELATIVE TO THE LOCATION OF PROPERTY LINES.

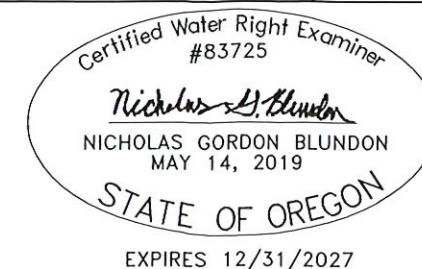

BLUNDON
ENGINEERING, LLC

PO BOX 786
HILLSBORO, OREGON 97123
541-510-5910
NICK@BLUNDONENGINEERING.COM