

THIS MAP WAS PREPARED FOR ASSESSMENT PURPOSE ONLY.

SEC.17 T.26S. R.3W. W.M.  
DOUGLAS COUNTY


REVISED ON  
3-16-20

26 3 17  
& INDEX

1" = 400'  
TAXLOT = 301

SEE MAP 26 3 00

↑ N  
house  
• POD  
↓  
(43.30949  
-123.08292)

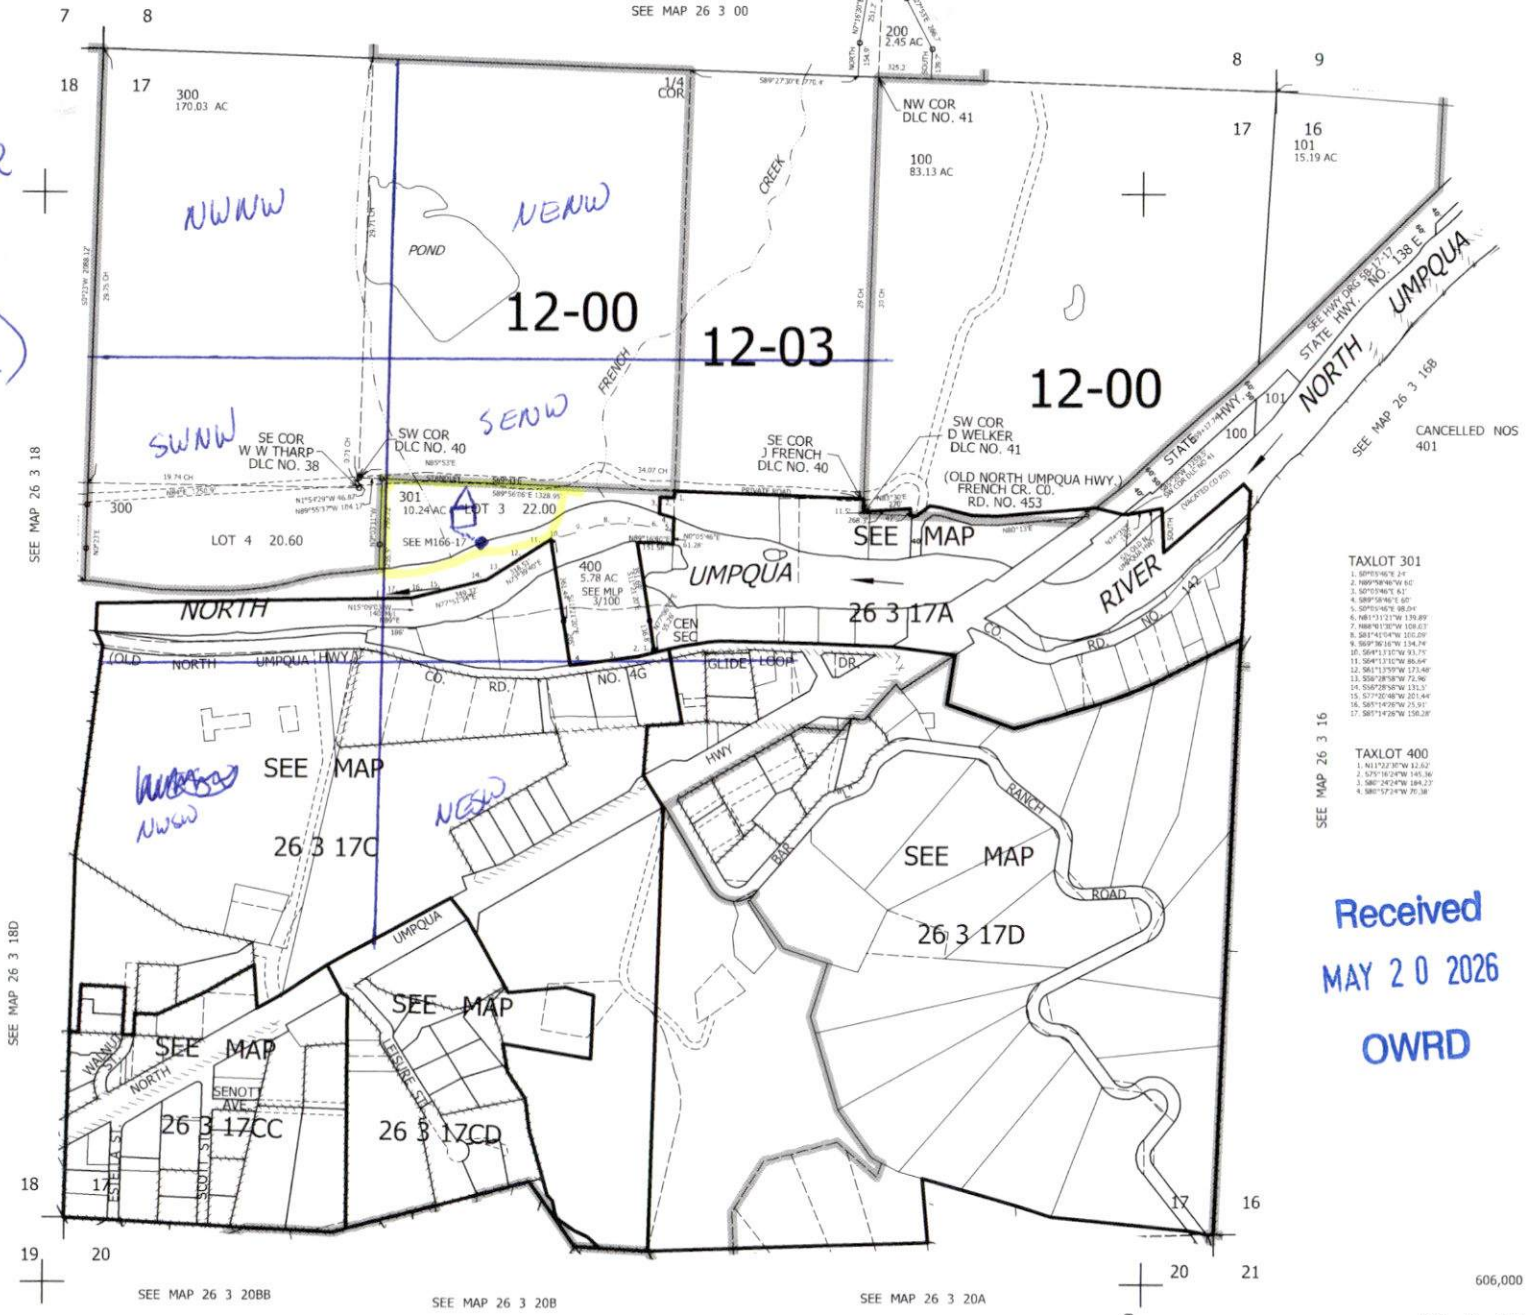

- TAXLOT 301


Received  
MAY 20 2026  
OWRD

• POD - 2350' S, 1650' E From NW corner, sec 17

26 3 17  
& INDEX