


TAX LOT 300
T. 7 N., R. 10 W., SECTION 22, W.M.
CLATSOP COUNTY, OREGON

SCALE: 1" = 600'

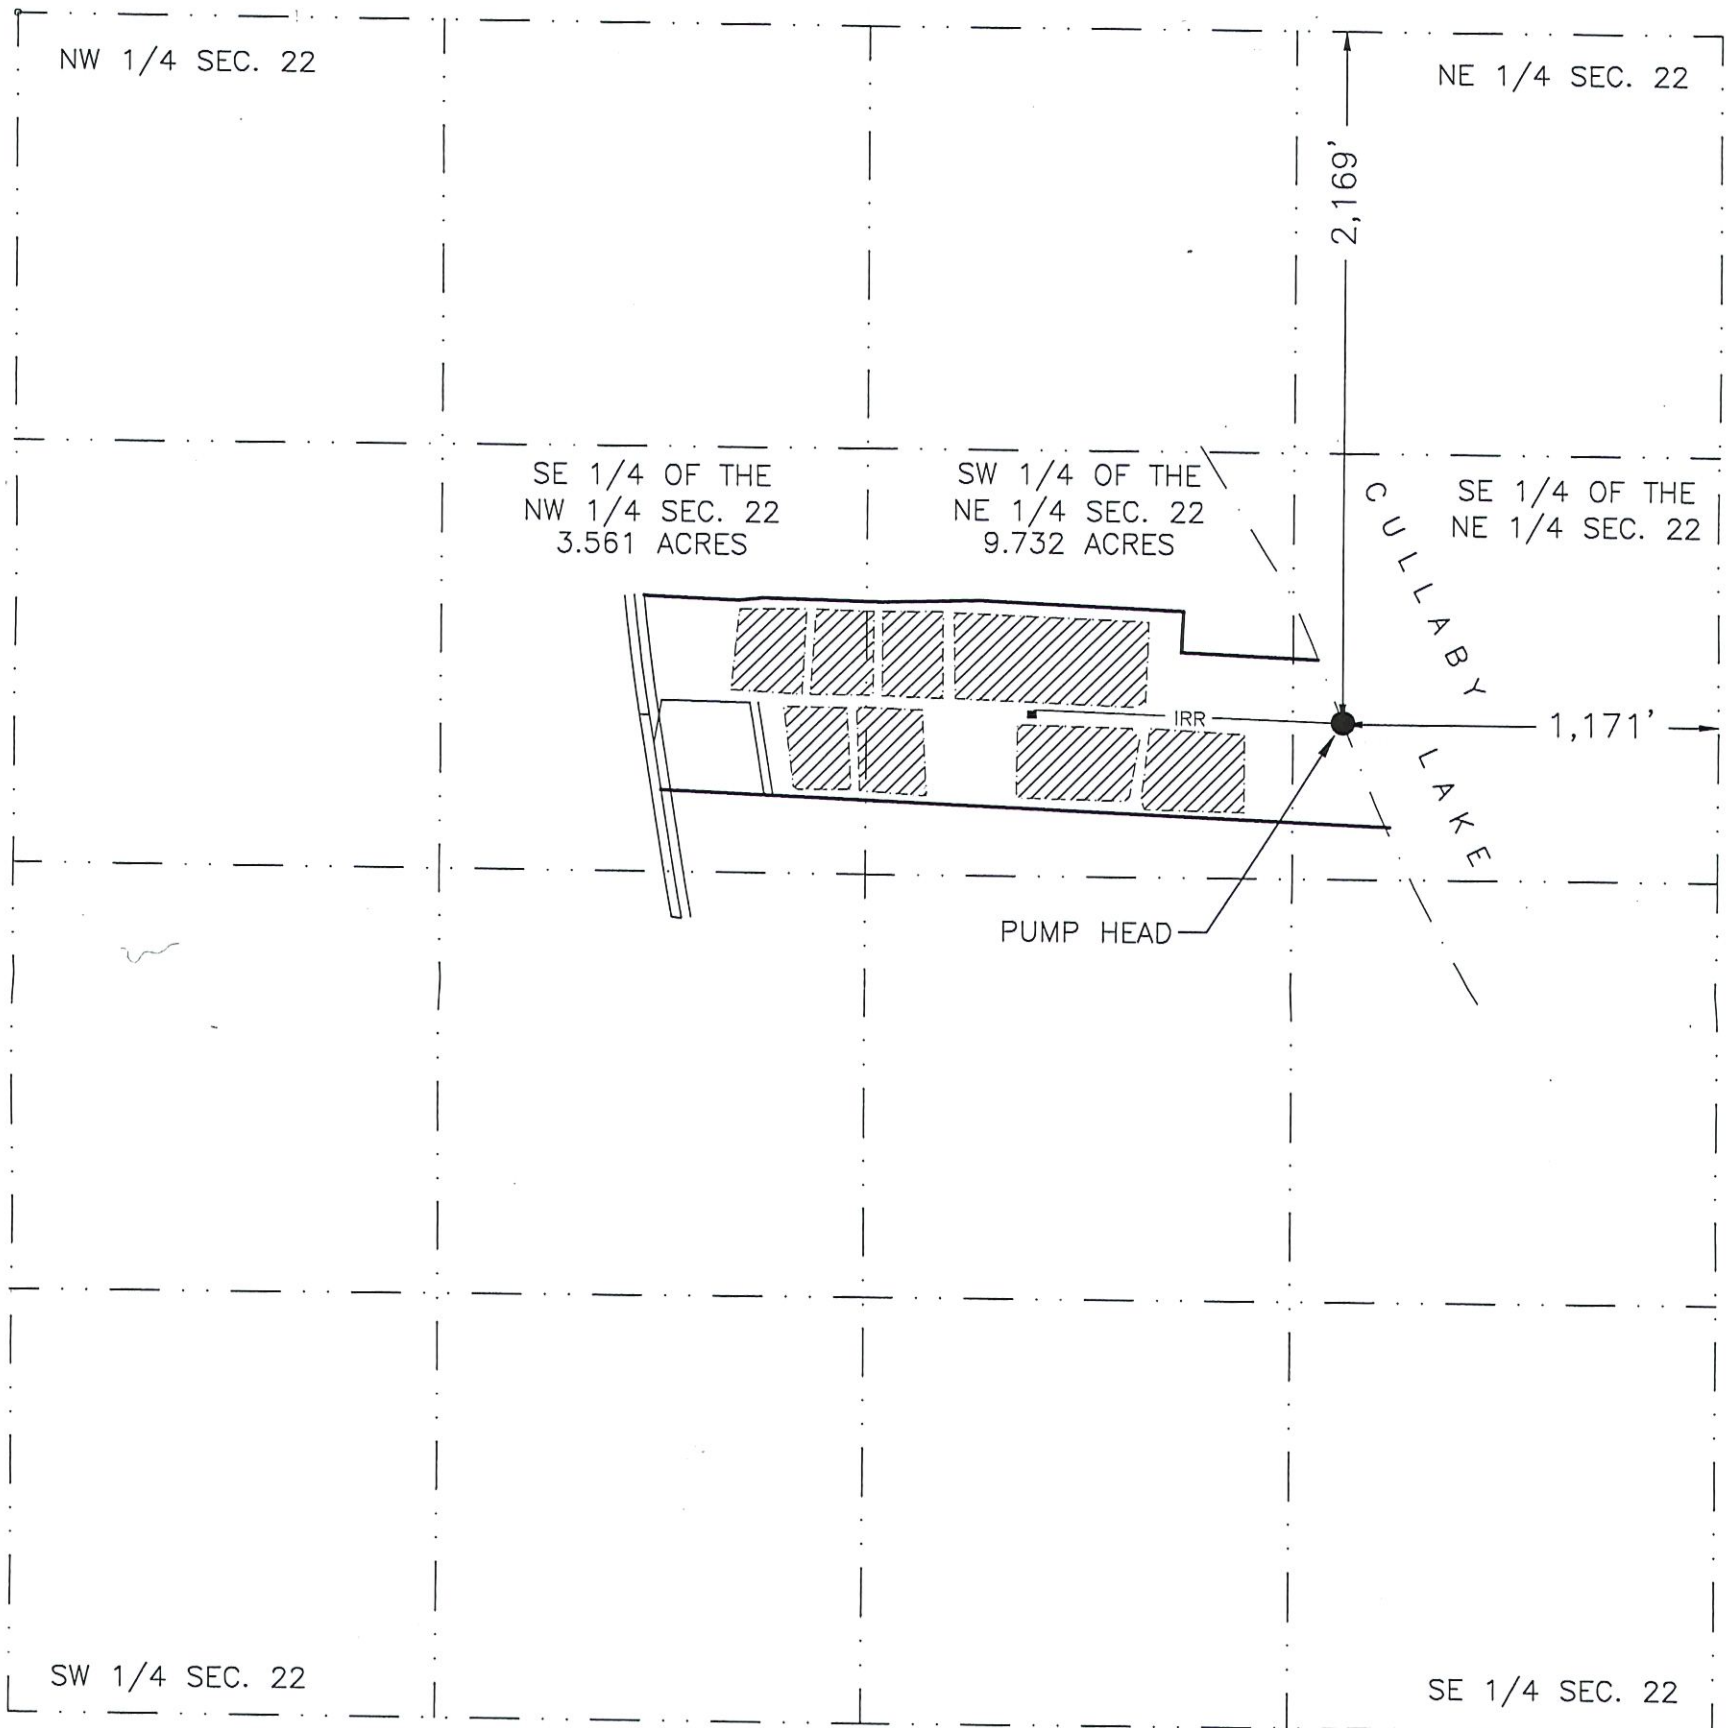


EXISTING PUMP HEAD IS 2,169 FEET SOUTH AND 1,1171 WEST
OF THE NE CORNER OF SECTION 22



= IRRIGATED CRANBERRY BOG

Received
MAY 21 2026
OWRD

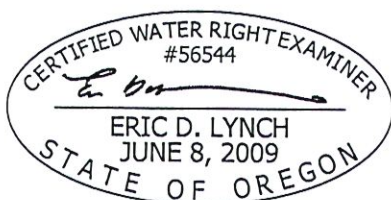

RENEWS: 12/31/2026

Date: 4/13/2026
Proj No: 26-G827-01

WWW.SFLANDS.COM

S&F Land Services


Land Surveying & Remote Sensing

4905 SW SCHOLLS FERRY RD.
PORTLAND, OR 97225
(503) 345-0328

EMAIL: INFO@SFLANDS.COM

TAX LOT 300
T. 7 N., R. 10 W., SECTION 22, W.M.
CLATSOP COUNTY, OREGON

SCALE: 1" = 600'

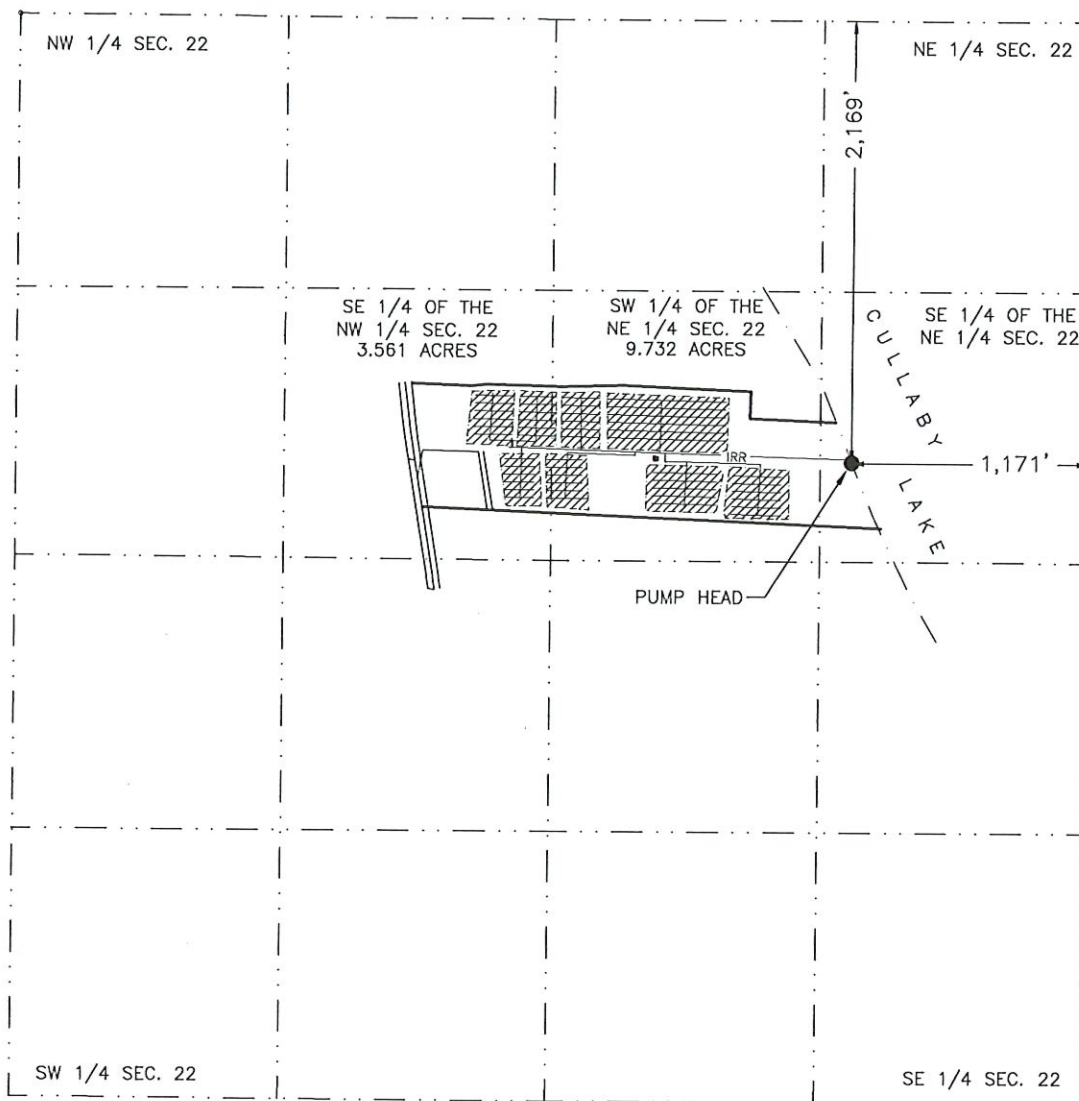

 = MAIN LINE TO LATERAL TO FEEDERS
WITH 472 SPRINKLERS

 = IRRIGATED CRANBERRY BOG

EXISTING PUMP HEAD IS 2,169 FEET SOUTH AND 1,171 WEST
OF THE NE CORNER OF SECTION 22

PUMP HEAD COORDINATES:
W123.90430* / N47.20250*
NAD 83



S&F Land Services

Land Surveying & Remote Sensing

4905 SW SCHOLLS FERRY RD.
PORTLAND, OR 97225
(503) 345-0328

Date: 5/18/2026

Proj No: 26-G827-01

WWW.SFLANDS.COM

EMAIL: INFO@SFLANDS.COM