


REVISION	BY
5/08/2026	RC

P.O. BOX 28
LAKEVIEW, OR. 97630
WWW.SHN-ENGR.COM
541-947-4407

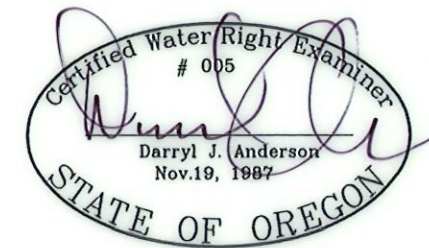

SCALE: 1"=1320'

————— SECTION LINE
 ————— 1/4 SECTION LINE
 — — — — — 1/16 SECTION LINE
 - - - - - TAXLOT LINE

Received
MAY 26 2026
OWRD

FOR:
DWDWIGHT ROTH
P.O. BOX 107
CHRISTMAS VALLEY, OR
97641

DATE:	2/03/2026
SCALE:	1" = 1320'
DWG. BY:	R.C.
JOB:	225106
FILE:	225106
SHEET:	1 OF 1

- | | |
|---|---|
|  | PLACE OF USE FROM
CERTIFICATE 53450- 4.10 ACRES
POA - WELL 8 |
|  | PLACE OF USE FROM
CERTIFICATE 53452 - 5.10 ACRES
POA - WELL 8 |
|  | PLACE OF USE FROM
CERTIFICATE 84982 - 9.10 ACRES
POA - WELL 8 |
|  | CHANGE OF POA ONLY - 123.40 ACRES
POA - WELL 9 |