
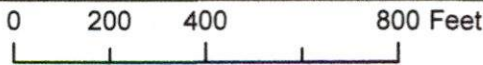


Claim of Beneficial Use - Grace Dinsdale

Application S-87892, Permit S-54932

Township 1N, Range 3W, W.M.

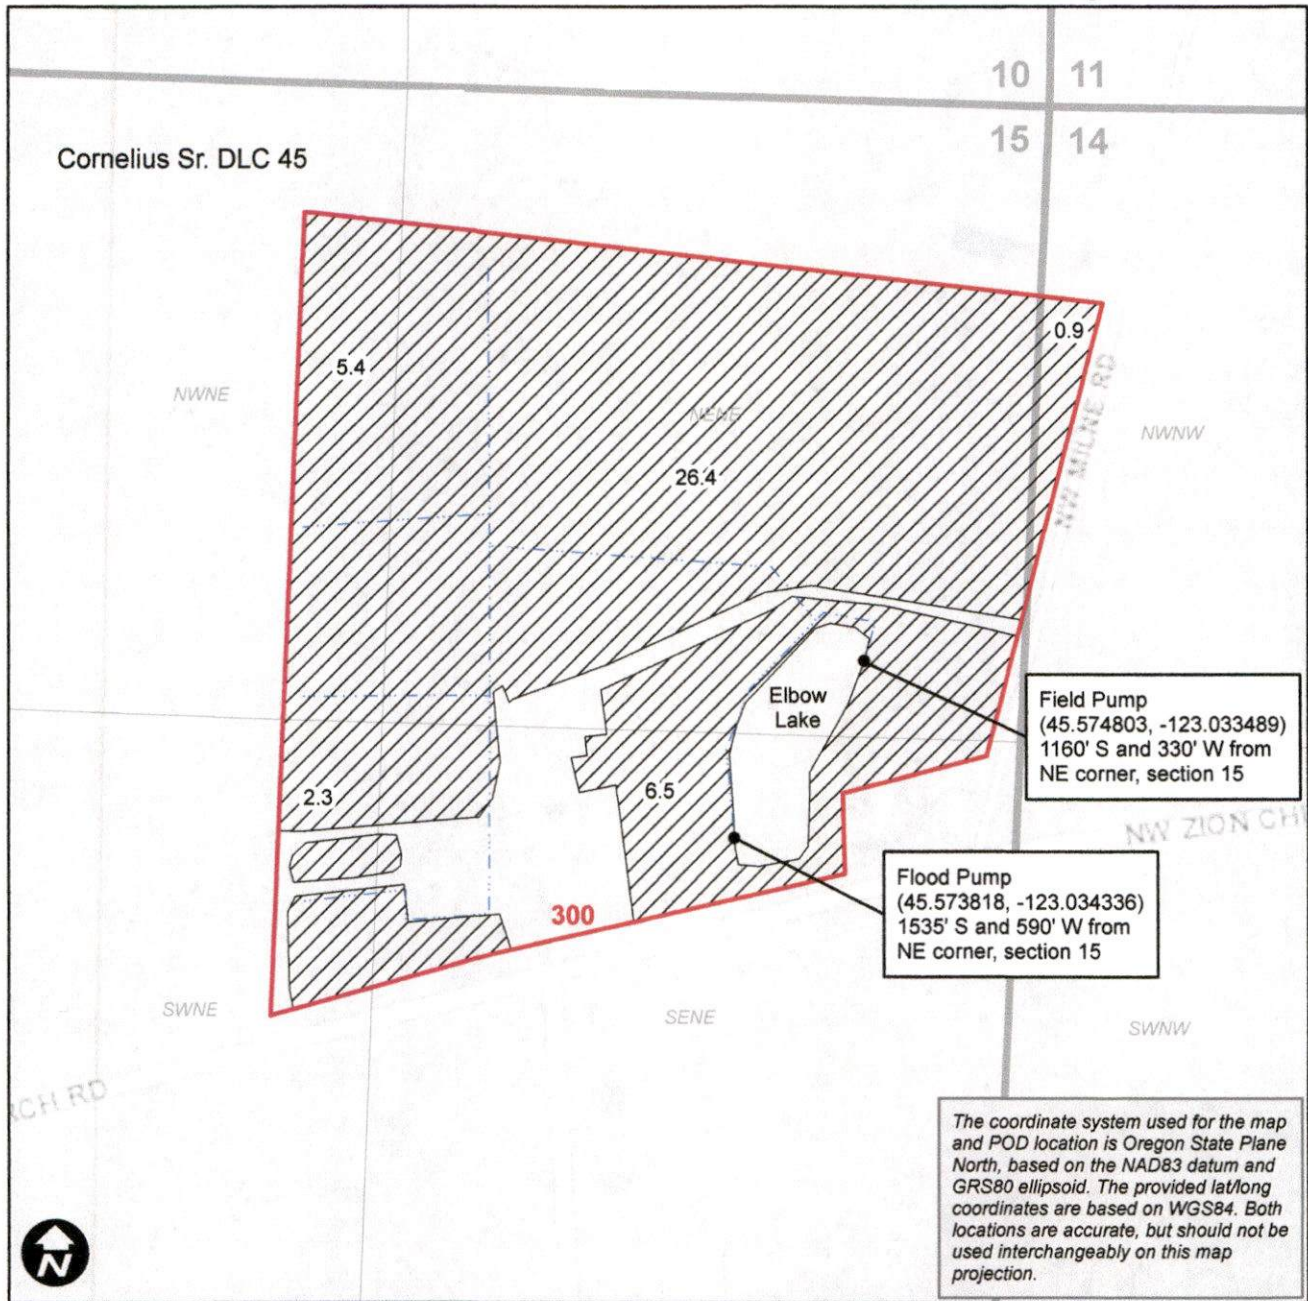

This map is not intended to provide legal dimensions or locations of property ownership lines.

Legend

- IR POU
- Mainline
- Taxlot



EXPIRES: 12-31-2026

Received by OWRD

MAY 29 2026

Salem, OR