


MAY 29 2026

Salem, OR

# Claim of Beneficial Use - Grace Dinsdale


Application R-87891, Permit R-15066

Township 1N, Range 3W, W.M.

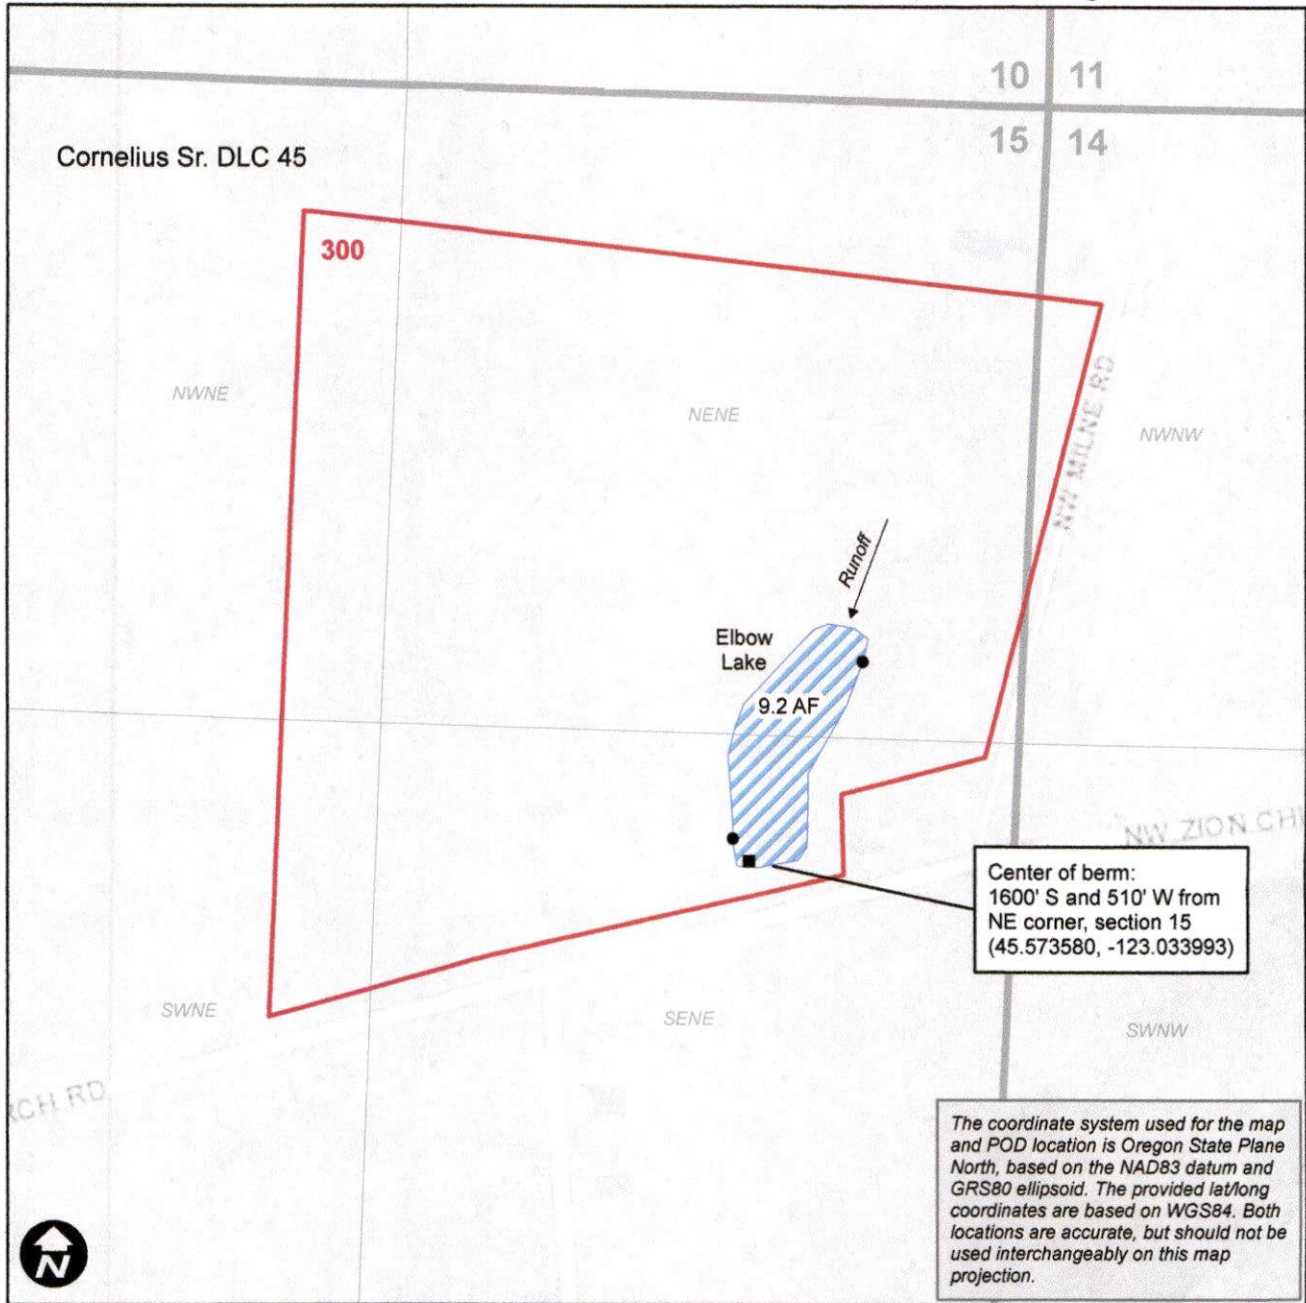

Center of berm:  
 1600' S and 510' W from  
 NE corner, section 15  
 (45.573580, -123.033993)

The coordinate system used for the map and POD location is Oregon State Plane North, based on the NAD83 datum and GRS80 ellipsoid. The provided lat/long coordinates are based on WGS84. Both locations are accurate, but should not be used interchangeably on this map projection.

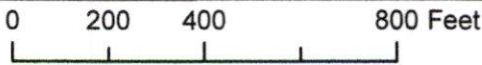

This map is not intended to provide legal dimensions or locations of property ownership lines.

## Legend

- Reservoir
- Taxlot
- Overflow Pipe
- Pumpsites



EXPIRES: 12-31-2026