

AMENDED MAP FOR TERRY CHRISTMAN APP S-89458

THIS MAP WAS PREPARED FOR
ASSESSMENT PURPOSE ONLY

0 200 400 600 Feet

SECTION 3 T.8S. R.46E. W.M.
BAKER COUNTY
1" = 400'

08S46E03



 IRRIGATED
GROUND


9 AC SWSW
2 AC SESW

 POND-POND
370' N : 1086' E
FR. SW CORN.
SECT 3.

--- IRR SYSTEM
FROM RESERVOIR

Received
MAY 29 2026

OWRD

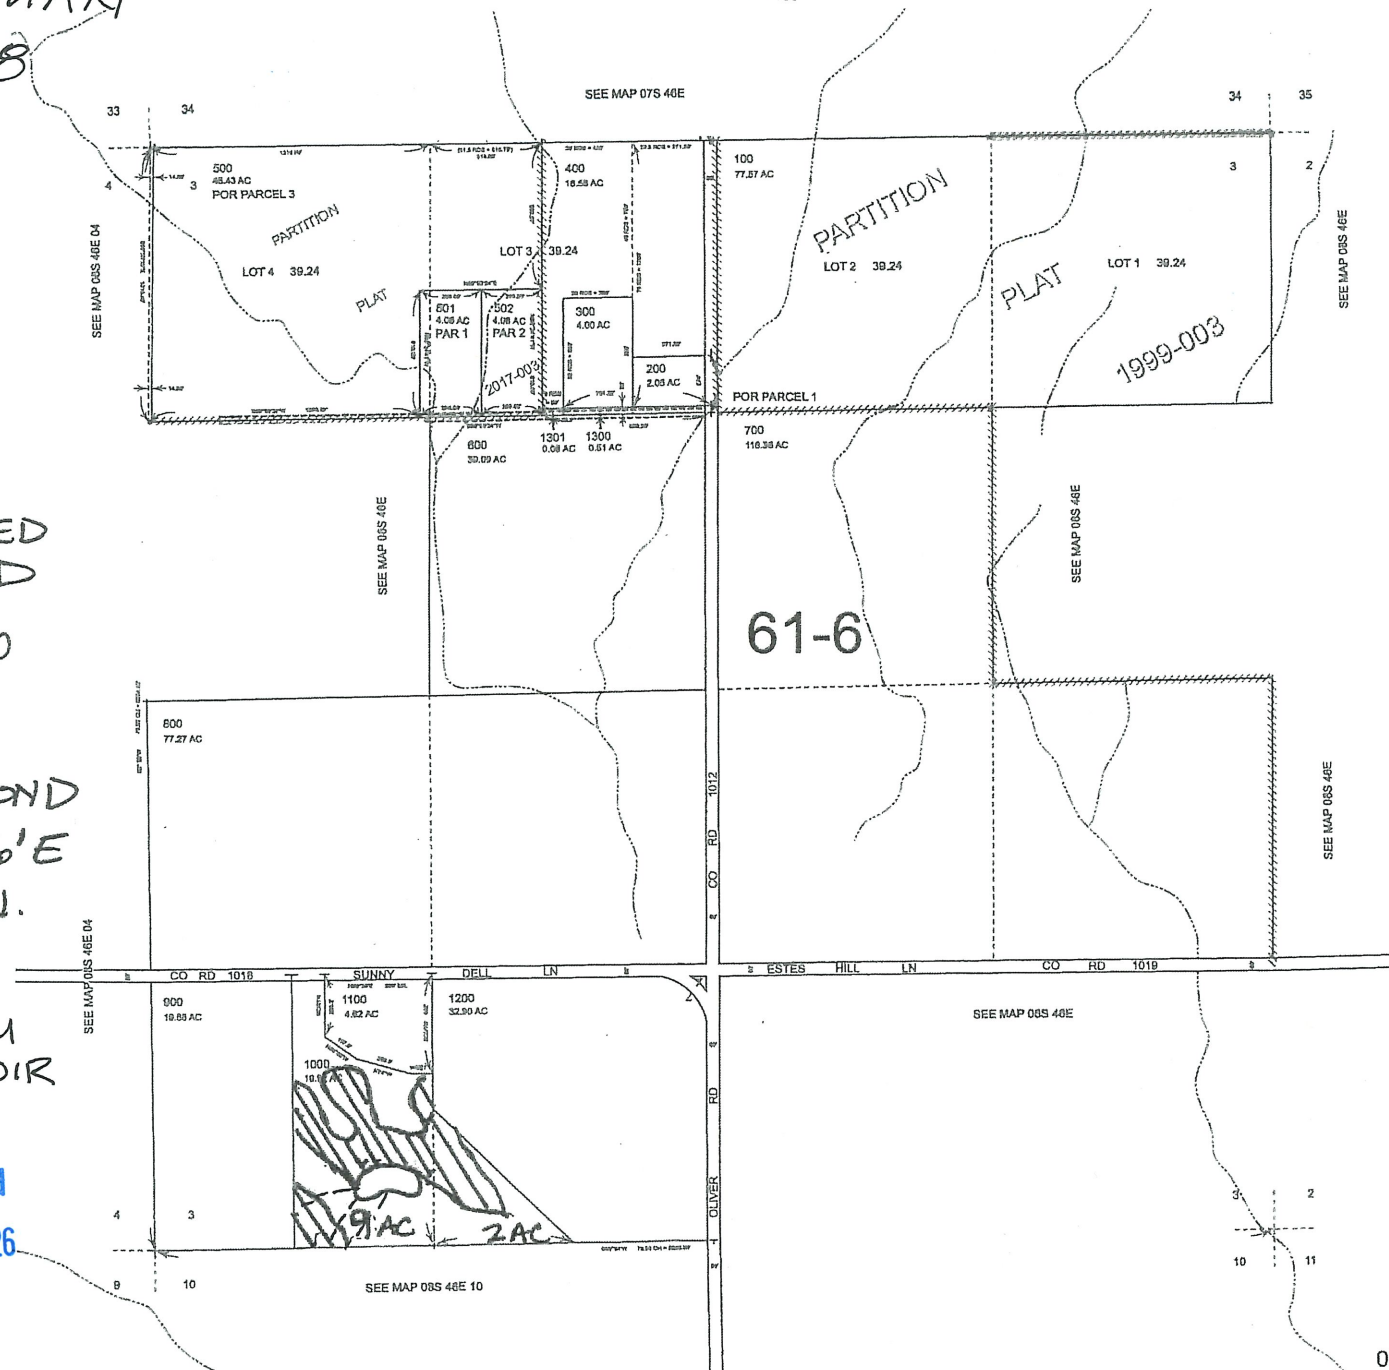

Revised: TK
09/15/2017

08S46E03