


T-9

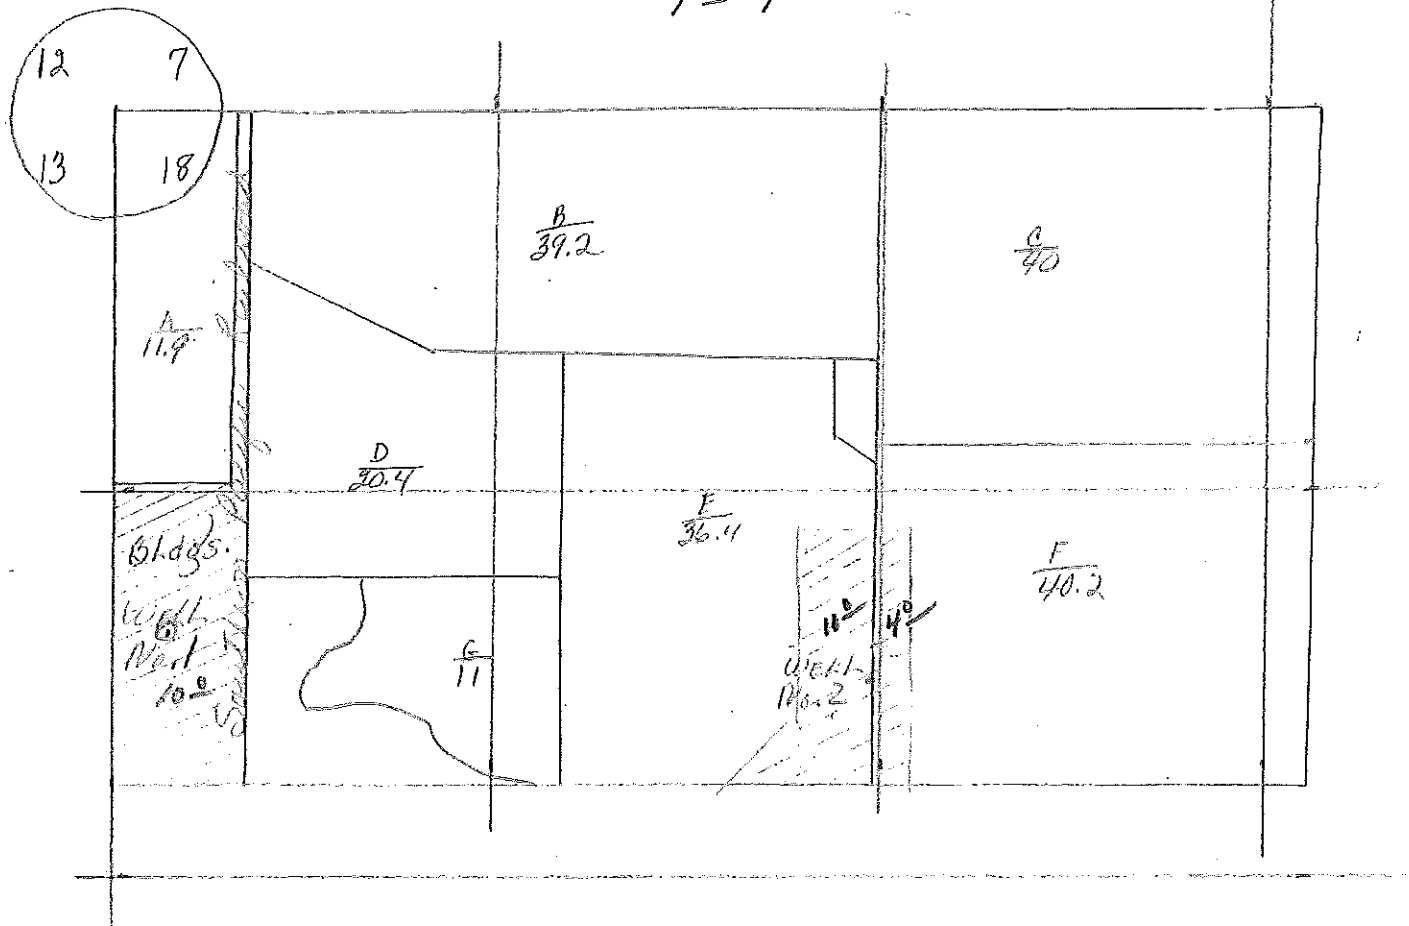

Map No. 40-122
S. 18 T. 125 R. 34W

GR-3779