


T-9

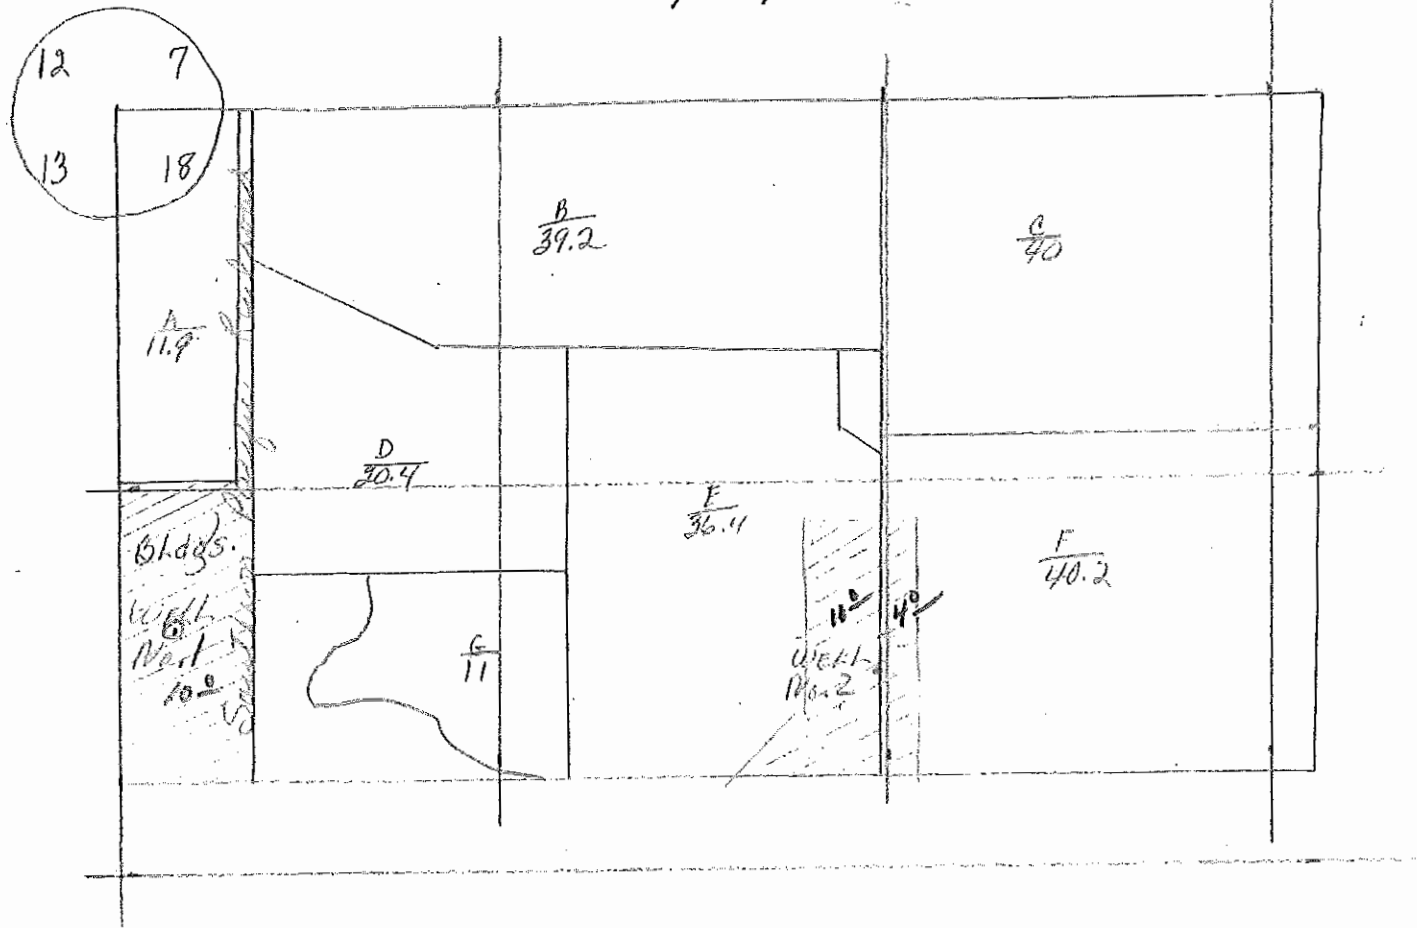

Map No. 40-122  
S 18 T 12 S R 3 E

GR-3779