

Claim of Beneficial Use - Jason Perrott



Application S-88754, Permit S-55214

Received by OWRD

JUN 02 2026

Salem, OR

Township 17S, Range 3W, W.M.

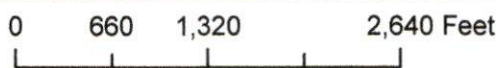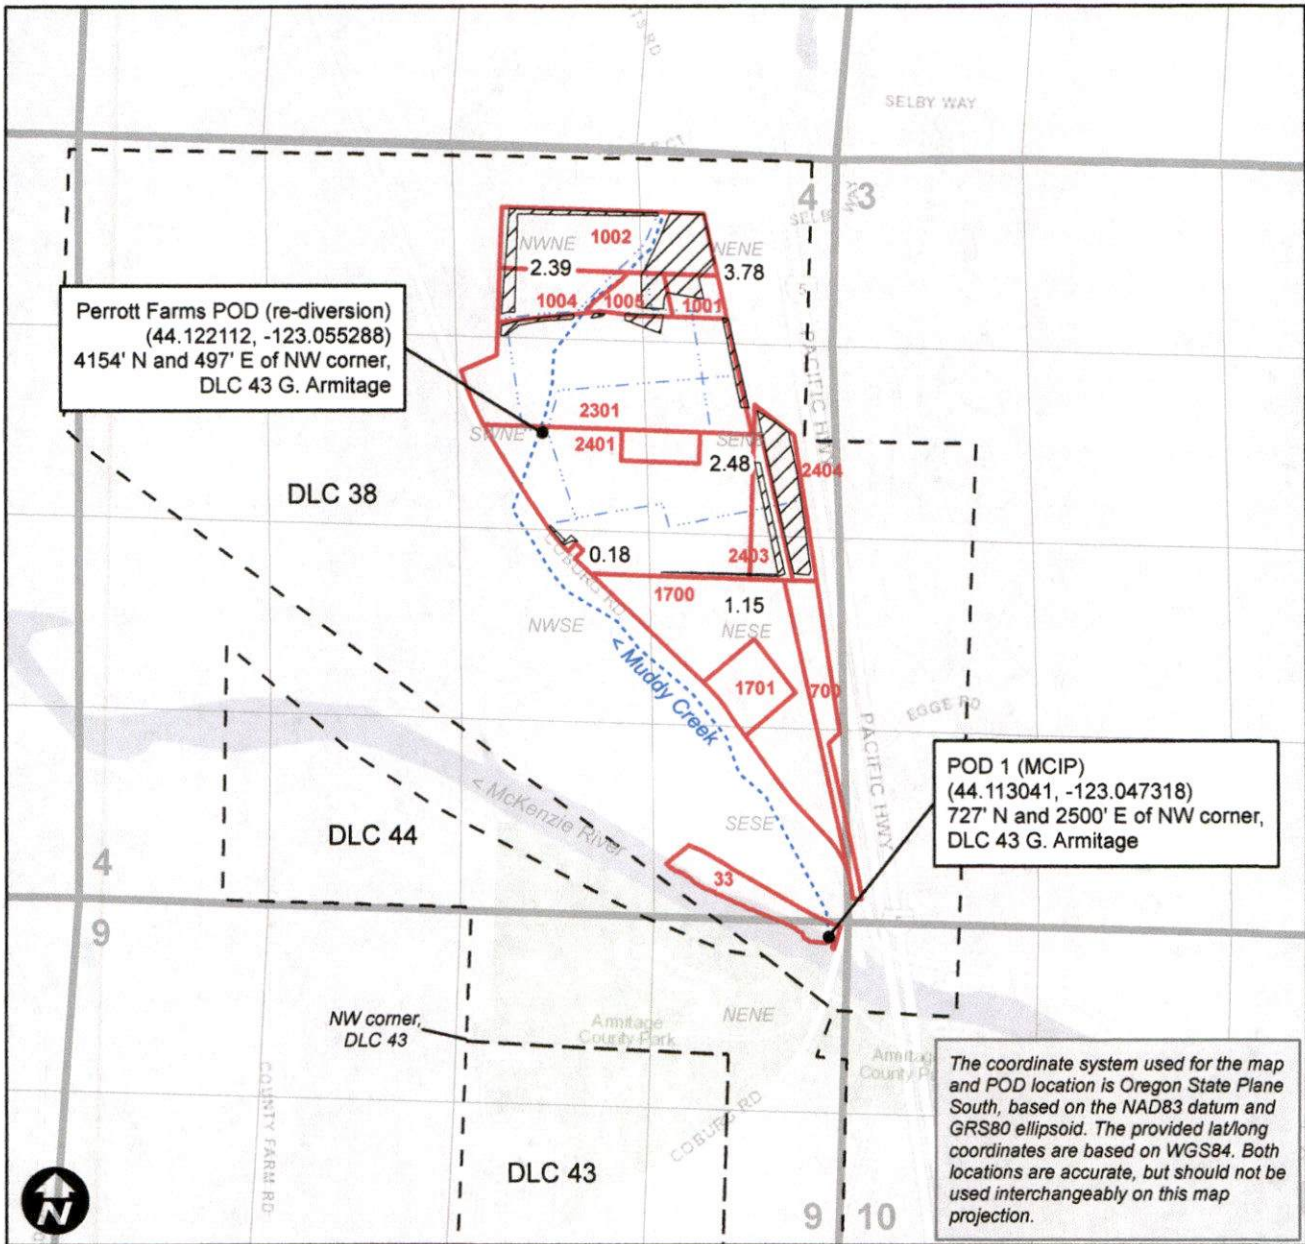

This map is not intended to provide legal dimensions or locations of property ownership lines.

Legend

- IR POU
- MCIP Ditch
- DLC
- Mainline
- Taxlots

