



JUN 05 2026

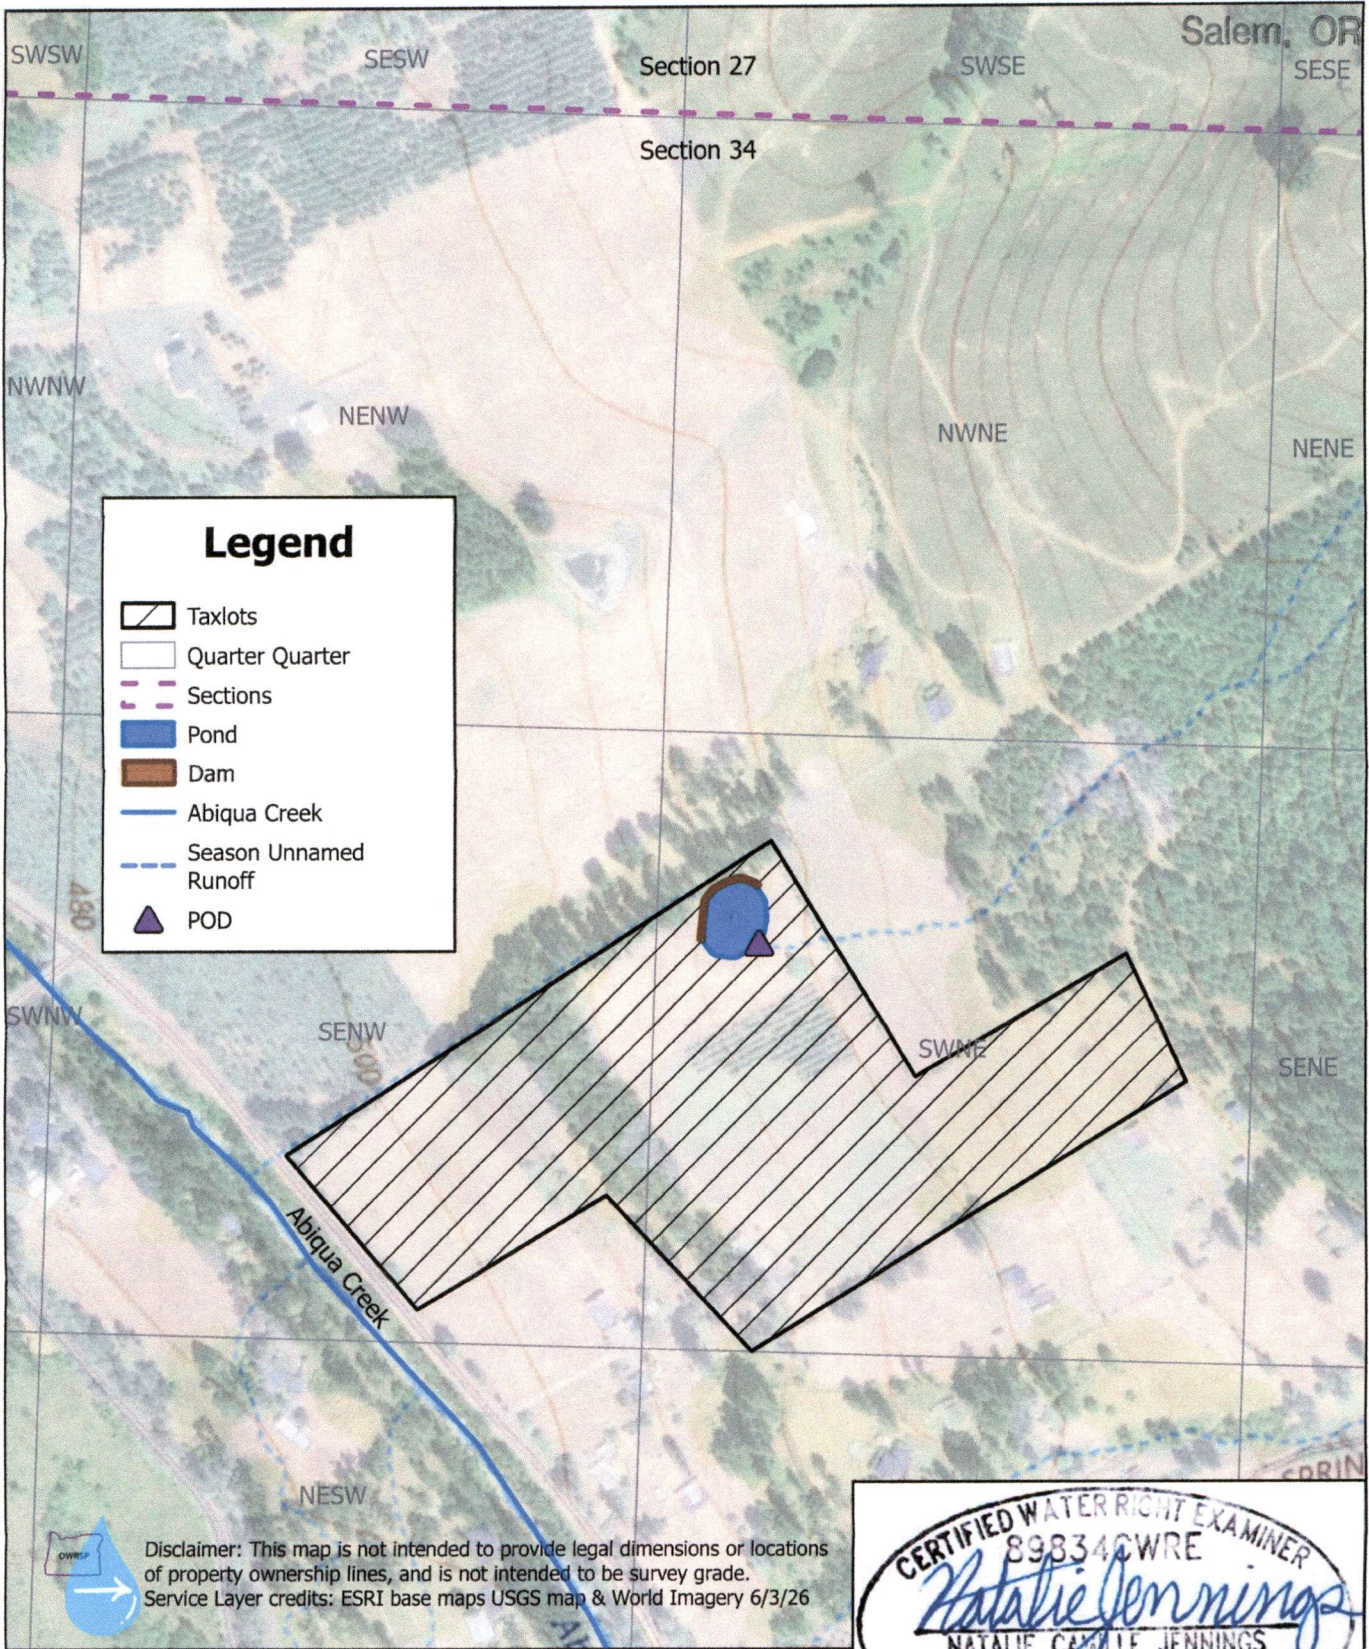

Legend

- Taxlots
- Quarter Quarter
- Sections
- Pond
- Dam
- Abiqua Creek
- Season Unnamed Runoff
- POD

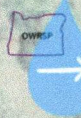

Disclaimer: This map is not intended to provide legal dimensions or locations of property ownership lines, and is not intended to be survey grade.
 Service Layer credits: ESRI base maps USGS map & World Imagery 6/3/26

CERTIFIED WATER RIGHT EXAMINER
 89834CWRE
Natalie Jennings
 NATALIE CAMILLE JENNINGS
 JUNE 03, 2016
 STATE OF OREGON
 RENEWS: 6/30/27

Scale 1"=400'
 0 100 200 300 400 Feet
 Reference corner: T6S R1E S 34 SWNE, NW Corner
 POD: 456 S & 228 ft E from reference corner
 Dam: 365 ft. S & 100 ft E from reference corner
 Base of dam 57ft. from center of pond, 224' long
 POU: 8.24 acres SE in NW, 13.55 acres in SWNE

Water Rights Map
 18987 Abiqua Rd. NE
 Scotts Mills, OR
 June 3, 2026

POD LAT: 45.008371
 LONG: -122.671561

DAM LAT: 45.008455
 LONG: -122.671754