


RECEIVED

JUN 24 1958

STATE ENGINEER
SALEM, OREGON

T5S, R3W

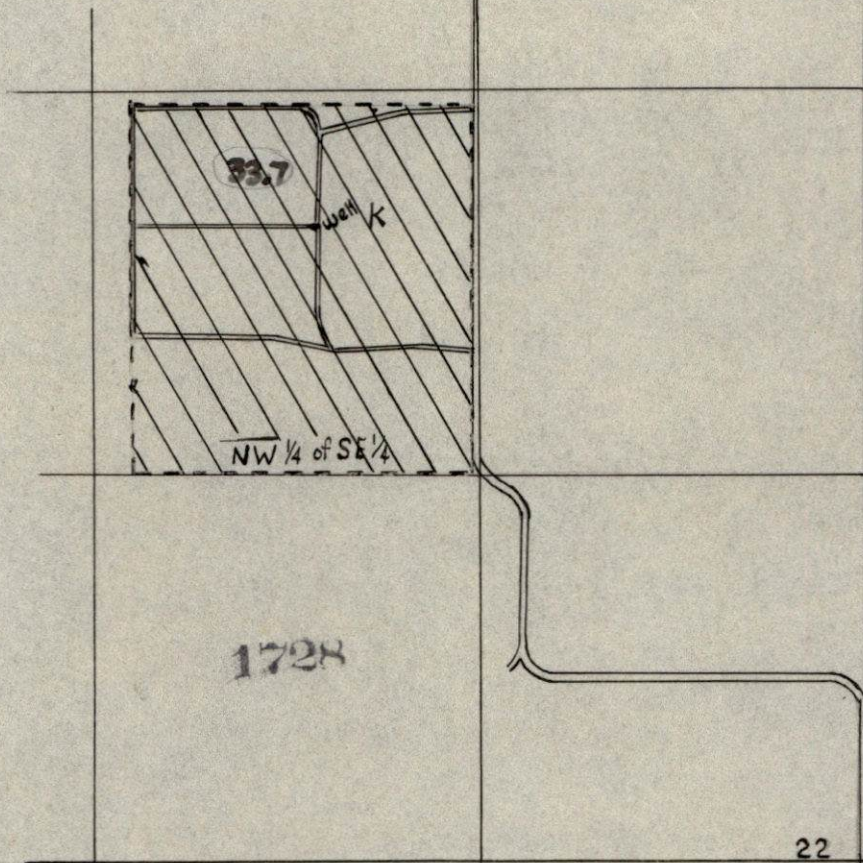

22 23
27 26

Scale 1"=660'

GR-1786

QML