


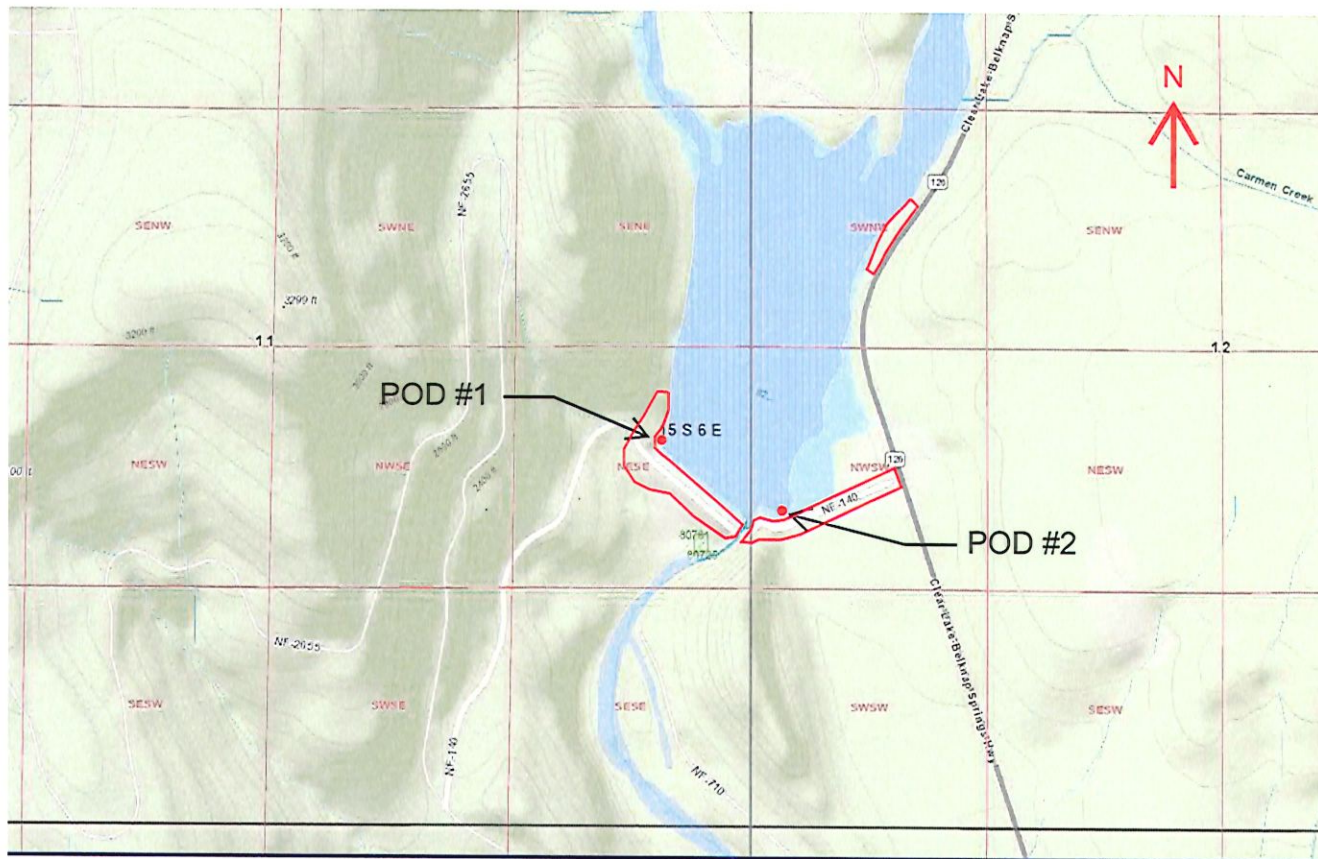

RECEIVED
JUN 12 2026
OWRD

Scale
1" = 1,000'

Legend

 Location for water use as
dust control/Fire Prevention

Datum	Latitude/Longitude
NAD83(2011)	POD #1 Lat: 44.274095 Long: -122.051091
	POD #2 Lat: 44.273115 Long: -122.048720

Site Information

POD #1
Township: 15S
Range: 06E
Section: 11
POD is 2,105' North and 470' West
of South East corner of section 11

POD #2
Township: 15S
Range: 06E
Section: 12
POD is 1,750' North and 150' East
of South West corner of section 12

44-2031