
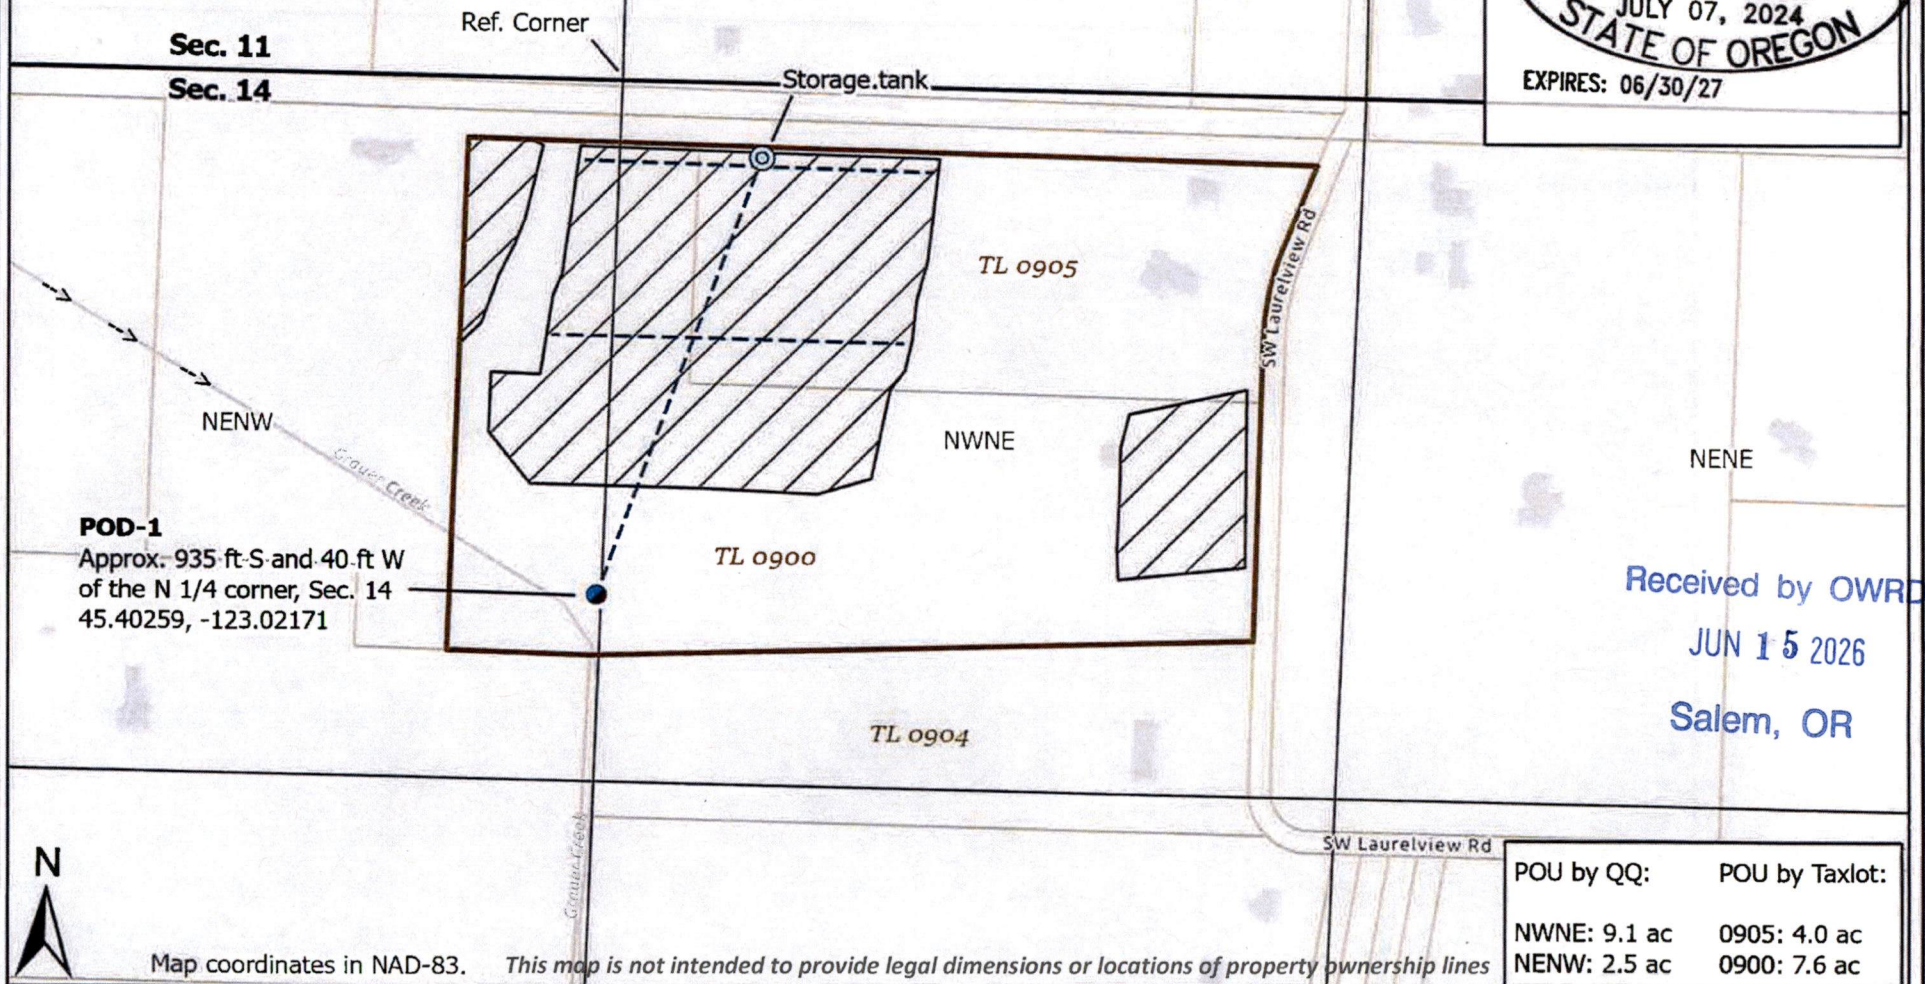


T-14426 (T2S, R3W, Sec 14)

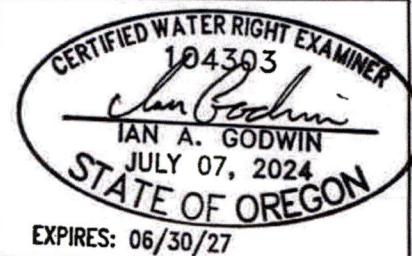

Received by OWRD
JUN 15 2026
Salem, OR

POU by QQ:	POU by Taxlot:
NWNE: 9.1 ac	0905: 4.0 ac
NENW: 2.5 ac	0900: 7.6 ac

CwM-H2O


Complete Water Management



311 B Avenue, Suite P
Lake Oswego, Oregon 97034
(503) 954-1326

ATTACHMENT 1
Transfer Claim of Beneficial Use
Map for Change in POU Only


1	DATE	AUTH	DRAFT
No.	Date	By	Revisions

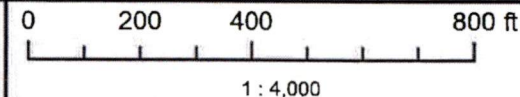

Proj#: 2405001
Roselli Transfer
Paola Roselli
32508 SW Laurelview Road
Hillsboro, OR 97123

- Claimed POU
- Point of Diversion
- Storage Tank
- Conveyance
- Taxlots

T-14426 (T2S, R3W, Sec 14)

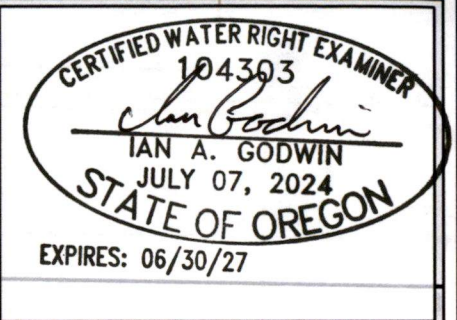

Sec. 11

Ref. Corner

Sec. 14

Storage tank

NENW

Grauer Creek

TL 0905

NWNE

NENE

POD-1

Approx. 935 ft S and 40 ft W
of the N 1/4 corner, Sec. 14
45.40259, -123.02171

TL 0900

TL 0904

SW Laurelview Rd

SW Laurelview Rd



Map coordinates in NAD-83.

Superseded

Received

JUN 12 2026

OWRD

POU by QQ: POU by Taxlot:

NWNE: 9.1 ac 0905: 4.0 ac
NENW: 2.5 ac 0900: 7.6 ac

CwM-H2O


Complete Water Management



311 B Avenue, Suite P
Lake Oswego, Oregon 97034
(503) 954-1326

ATTACHMENT 1
Transfer Claim of Beneficial Use
Map for Change in POU Only

1	DATE	AUTH	DRAFT
No.	Date	By	Revisions

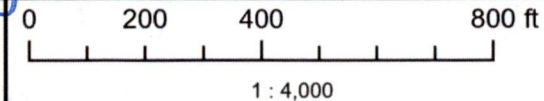

Proj#: 2405001
Roselli Transfer
Paola Roselli
32508 SW Laurelview Road
Hillsboro, OR 97123

- Claimed POU
- Point of Diversion
- Storage Tank
- Conveyance
- Taxlots