


Map coordinates in NAD-1983.

This map is not intended to provide legal dimensions or locations of property ownership lines.

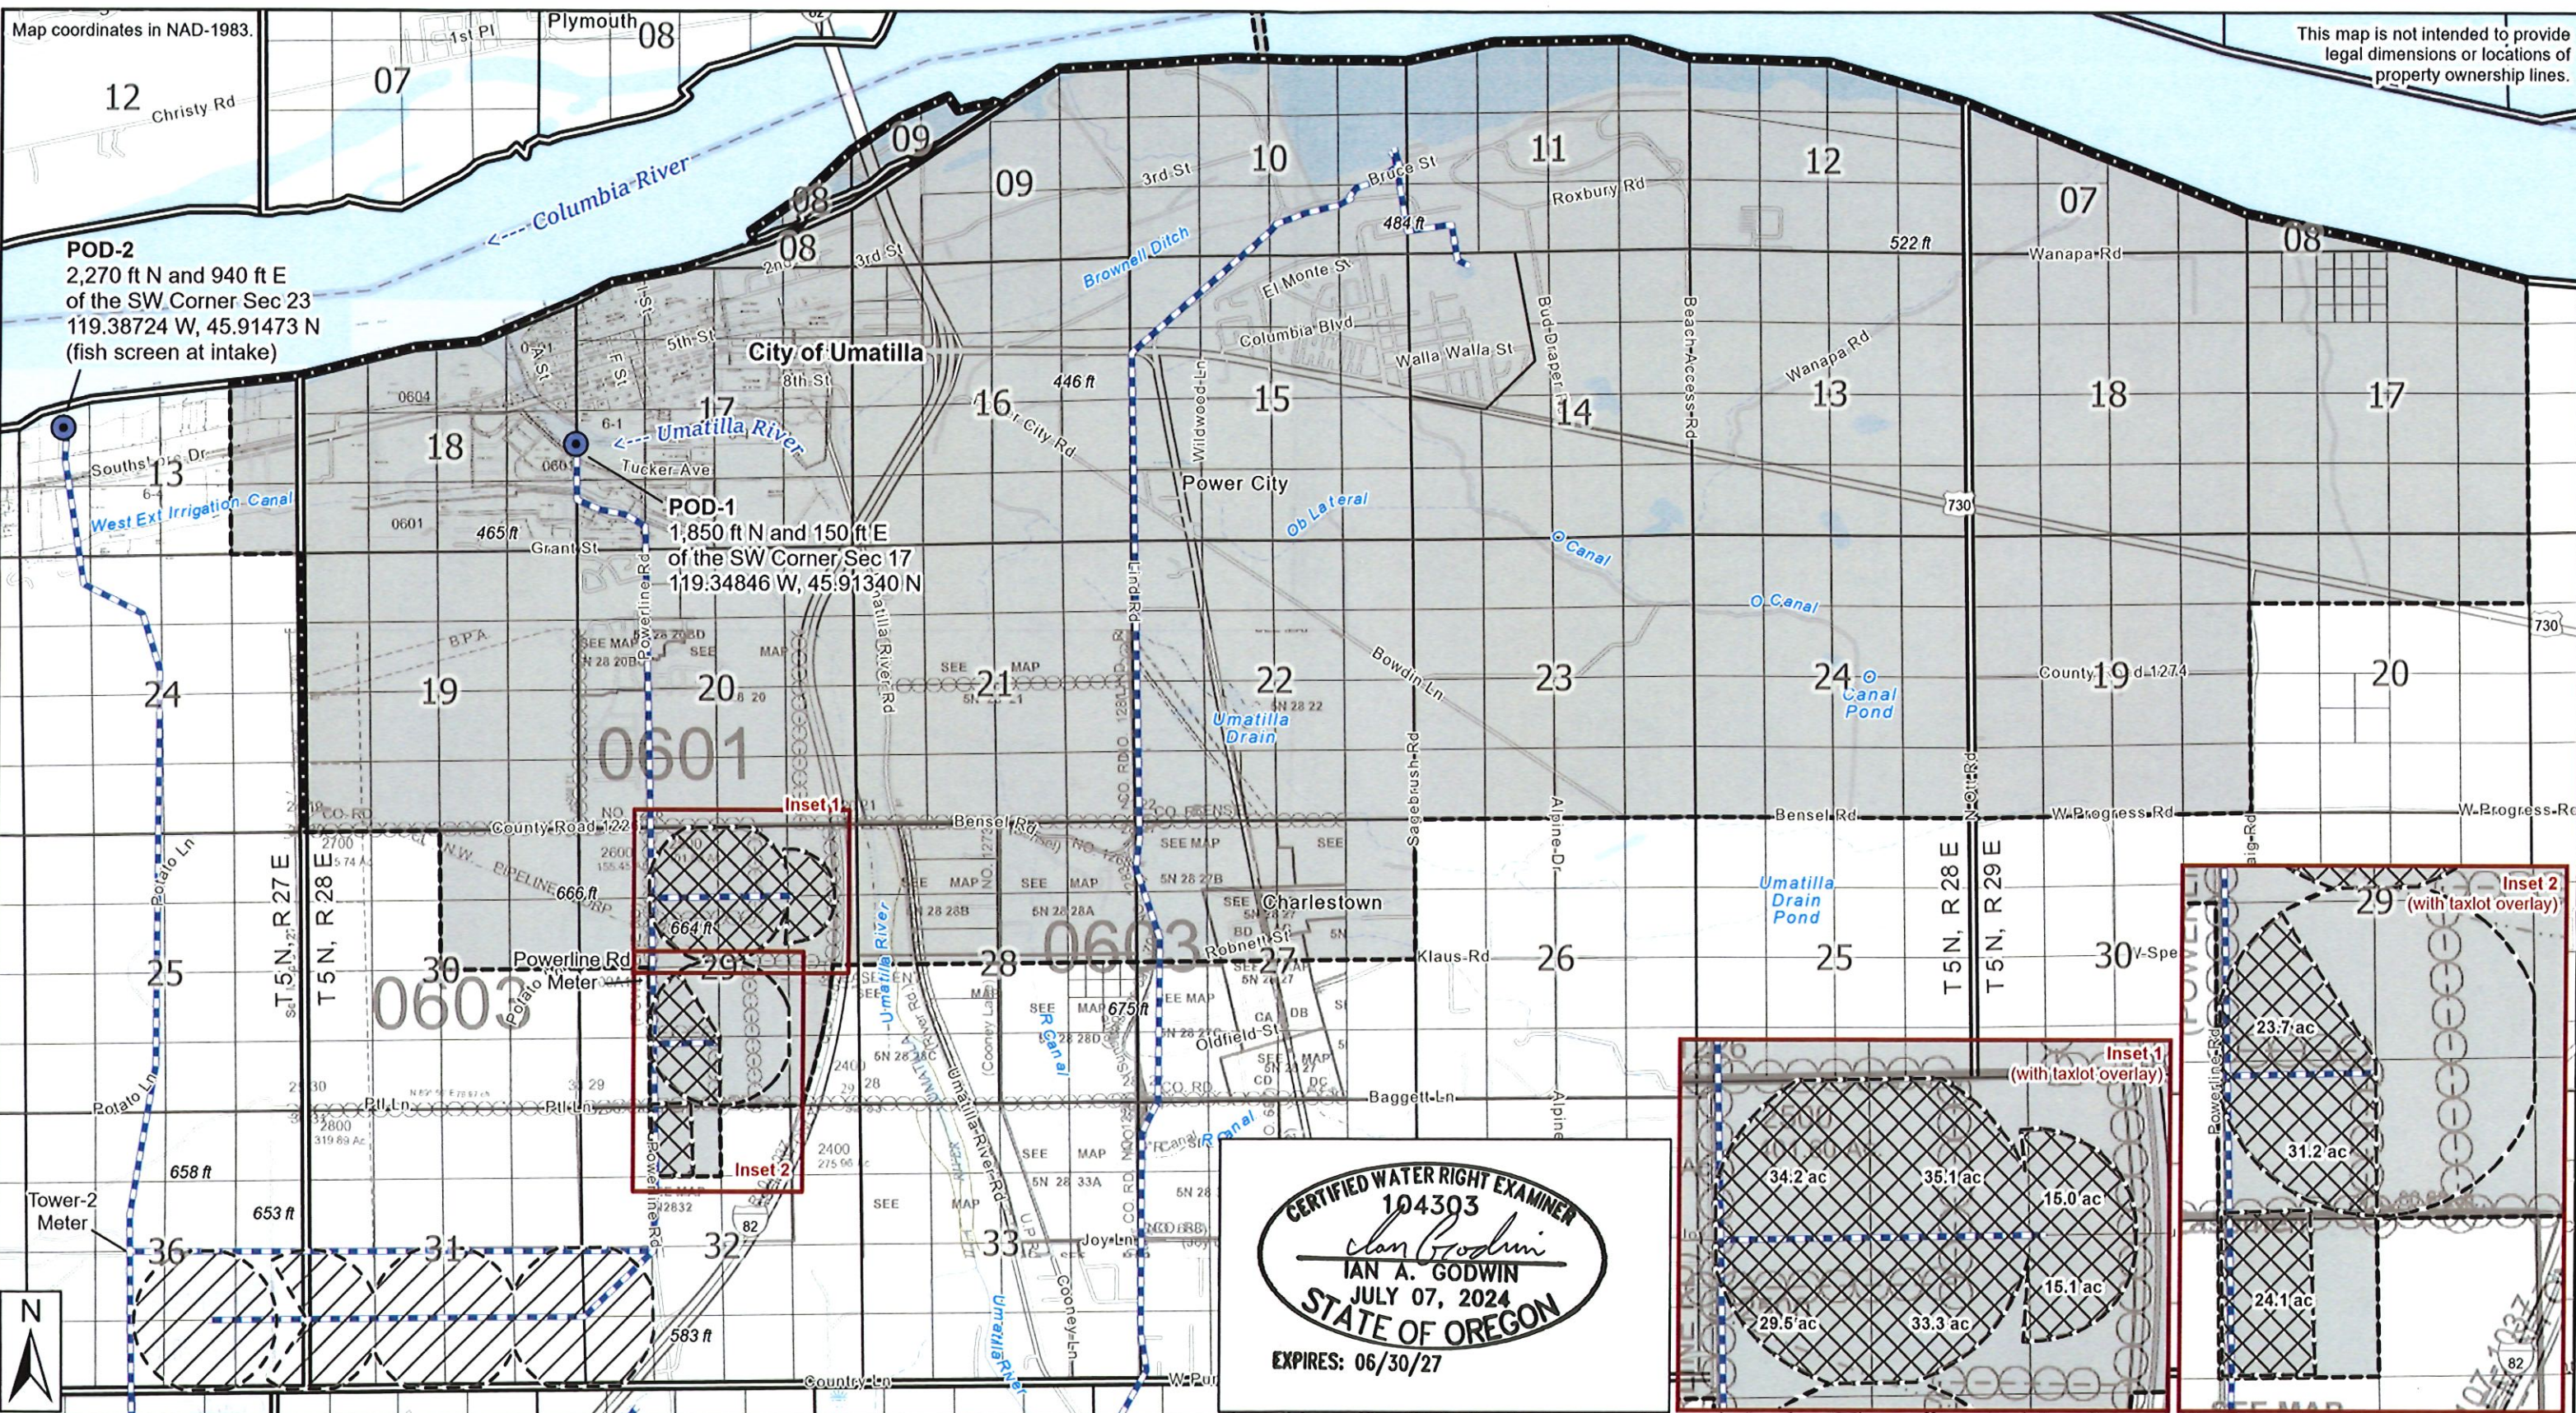

CERTIFIED WATER RIGHT EXAMINER
104303
IAN A. GODWIN
IAN A. GODWIN
JULY 07, 2024
STATE OF OREGON
EXPIRES: 06/30/27

CWM-H2O
Complete Water Management

311 B Avenue, Suite P
Lake Oswego, Oregon 97034
(503) 954-1326

ATTACHMENT 1
TRANSFER CLAIM OF BENEFICIAL USE
T5N, R27E, Sec 13, T5N, R28E, Sec 8-24, 27-30, 32,
T5N, R29E, Sec 7-8, 17-20

1	DATE	AUTHOR	DRAFT

Main Map 0 1,500 3,000 6,000 ft (1" = 3,000')
Inset Maps 0 500 1,000 2,000 ft (1" = 1,320')

Proj#: 2013004
Umatilla Transfer II
City of Umatilla
700 6th Street
Umatilla, OR 97882

- Points of Diversion
- Water Distribution Lines
- City Service Area / "To" Lands
- "From" Lands
- Cert. 96944 POU (underlying right)