


Claim of Beneficial Use - Garcia

Application G-18804, Permit G-18512

Township 8S, Range 1W, W.M.

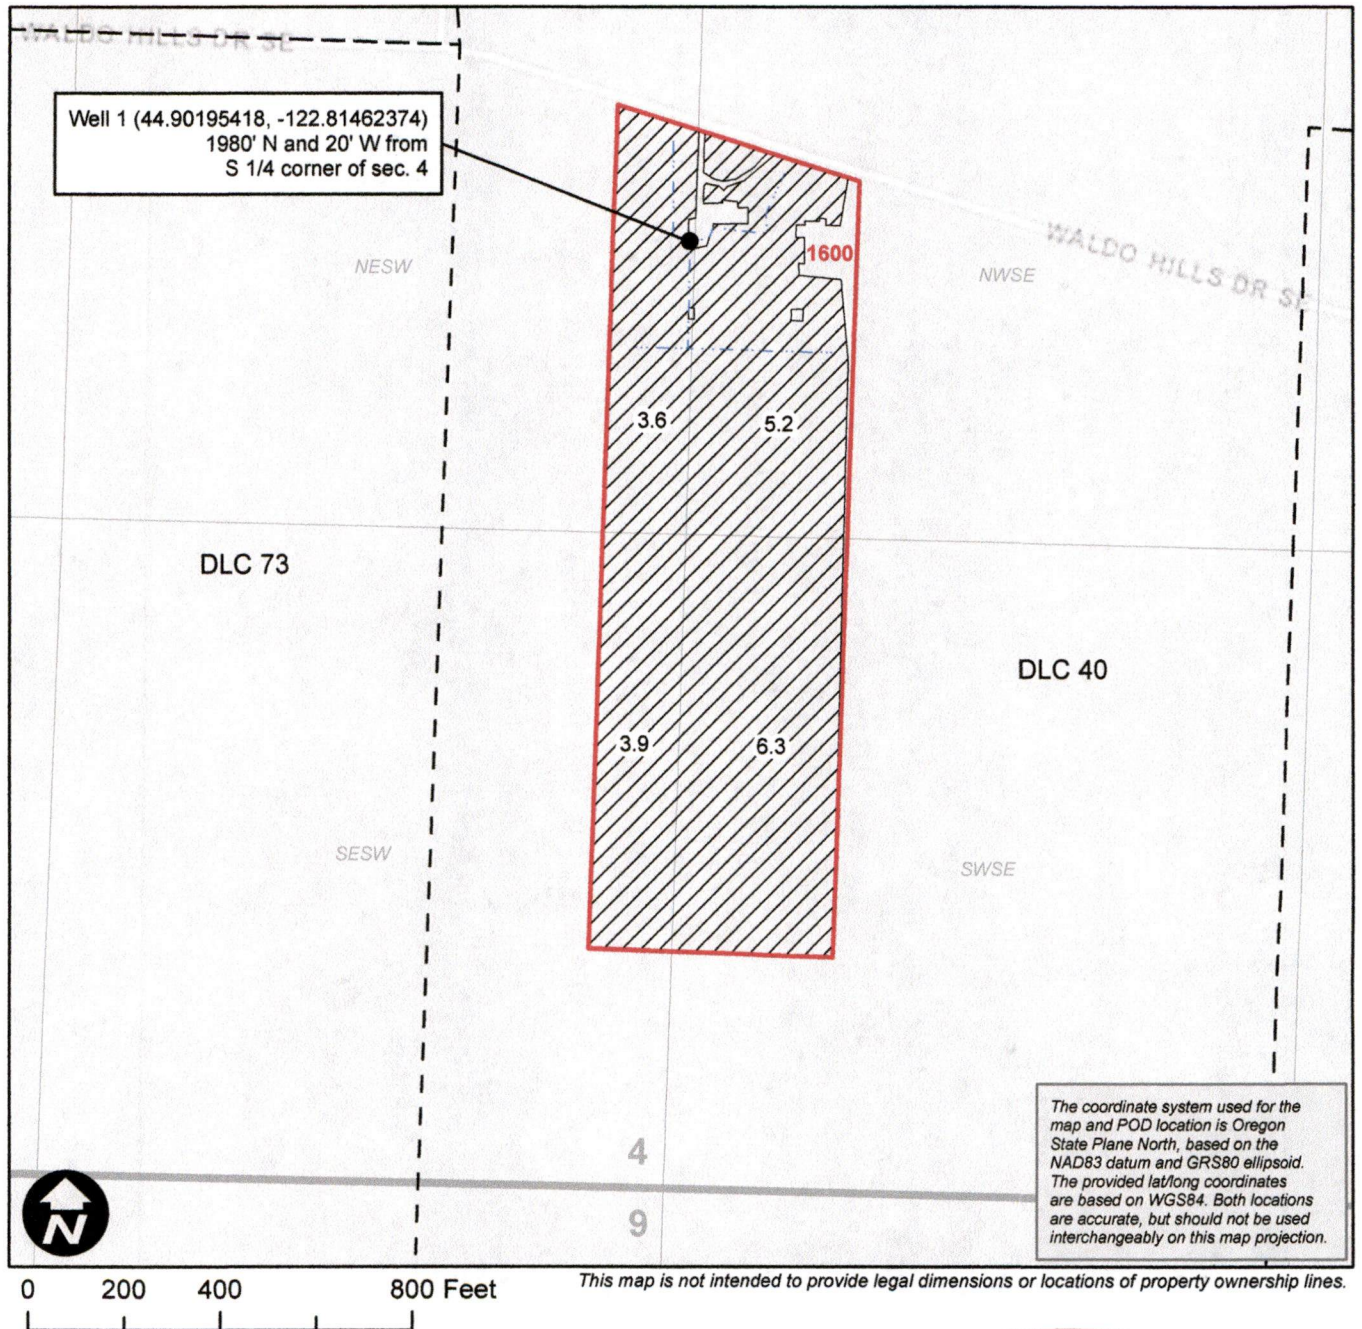

Legend

- IR POU
- DLC
- Mainline
- Taxlots

Received by OWRD

JUN 15 2026

Salem, OR



EXPIRES: 12/31/2026