


Claim of Beneficial Use - Gross, Justin Transfer T-14038

Township 11S, Range 3W, W.M.

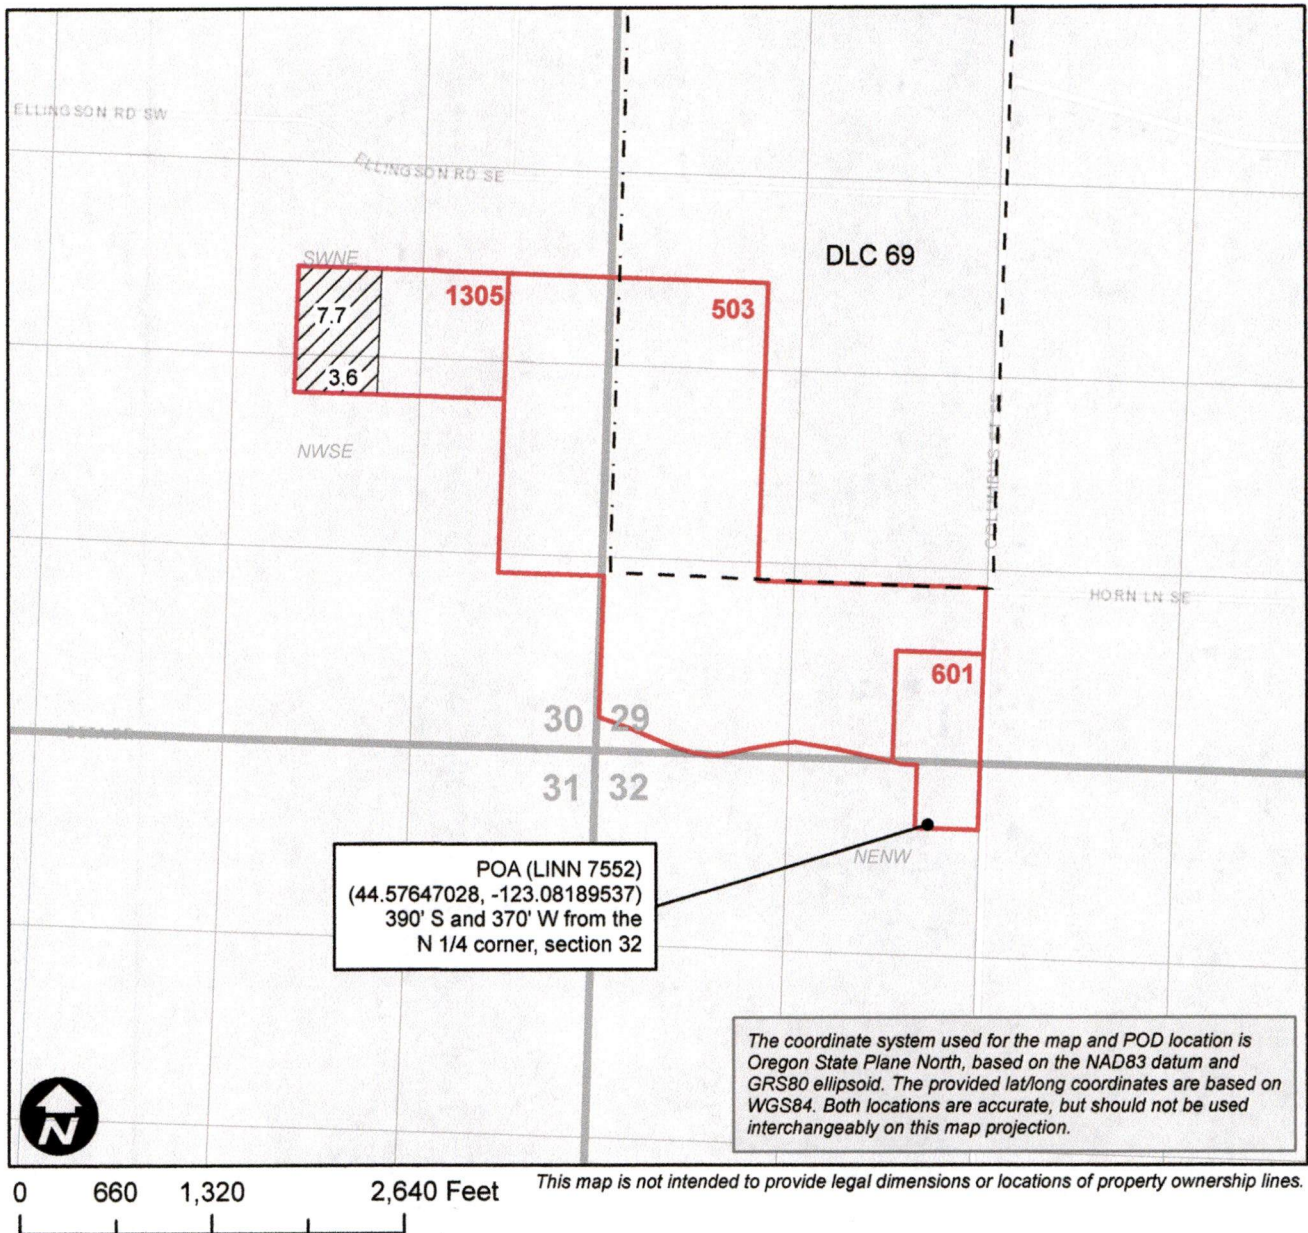

Legend

IR POU [] DLC [] Taxlots



Received by OWRD

JUN 15 2026

Salem, OR