


T. 31 S., R. 4 W., W.M.

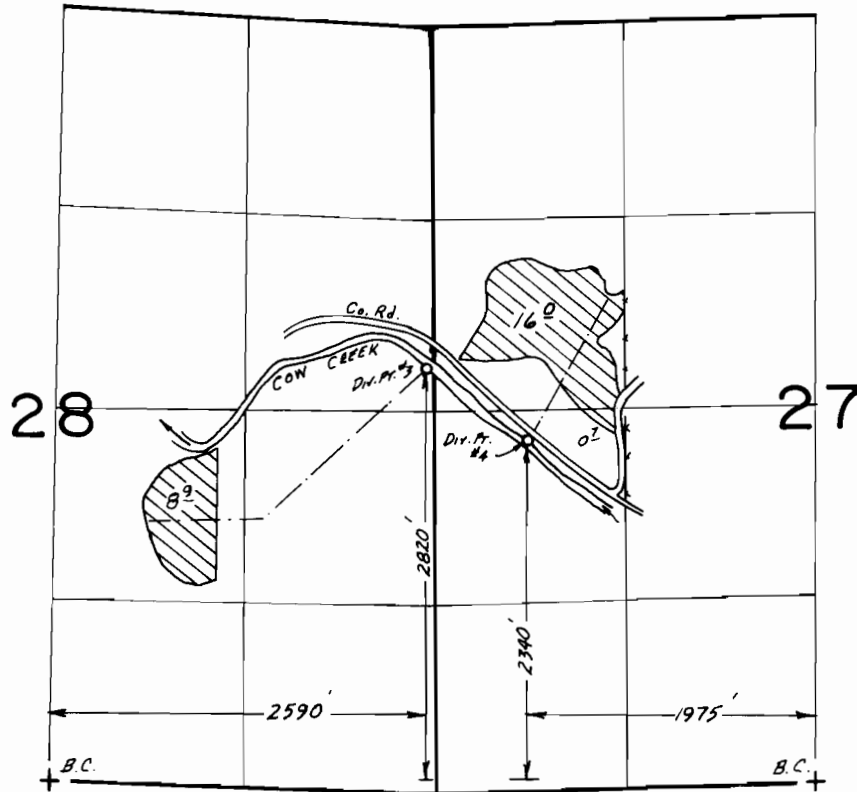

FINAL PROOF SURVEY
UNDER

Application No. 58427... Permit No. 44067.....
IN NAME OF

...GERALD S. & MARY LEE BRADY.....

Surveyed JULY 7..... 19.80., by J.S. DONALDSON