


Claim of Beneficial Use - Weyerhaeuser NR Co.
Application G-18946, Permit G-18539

Township 10S, Range 2W, W.M.

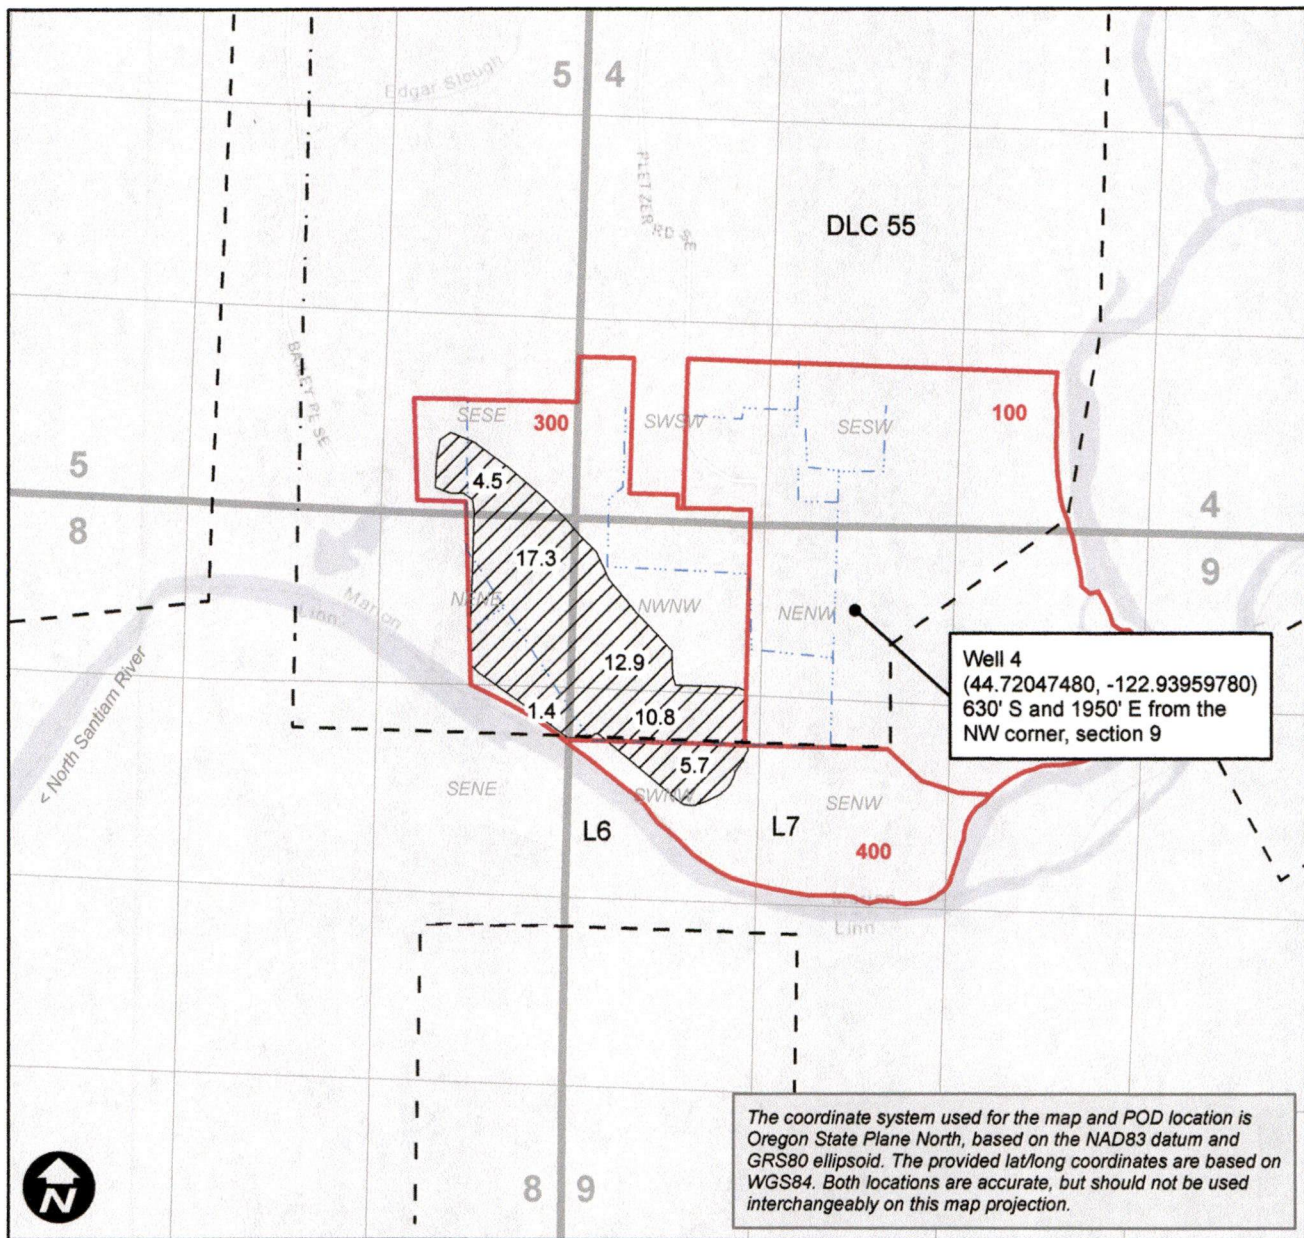

0 660 1,320 2,640 Feet

This map is not intended to provide legal dimensions or locations of property ownership lines.

Legend

- TC POU
 DLC
 Mainline
 Taxlots



Received by OWRD

JUN 15 2026

Salem, OR

EXPIRES: 12/31/2024