



**T23S R6E, WM
KLAMATH COUNTY, OR**

**Sec 14
TL 100**

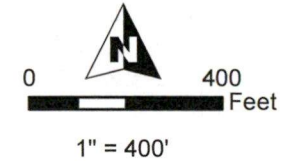

- POD
- Cabin & Meter
- - - Creek
- - - Edge of Odell Lake
- Pipeline
- Section
- Quarter Quarter
- Tax Lot

POD Location:
1510' N, 930' W of S 1/4 Cor Sec 14
Lat: 43.576947 Long: -121.976106 WGS1984

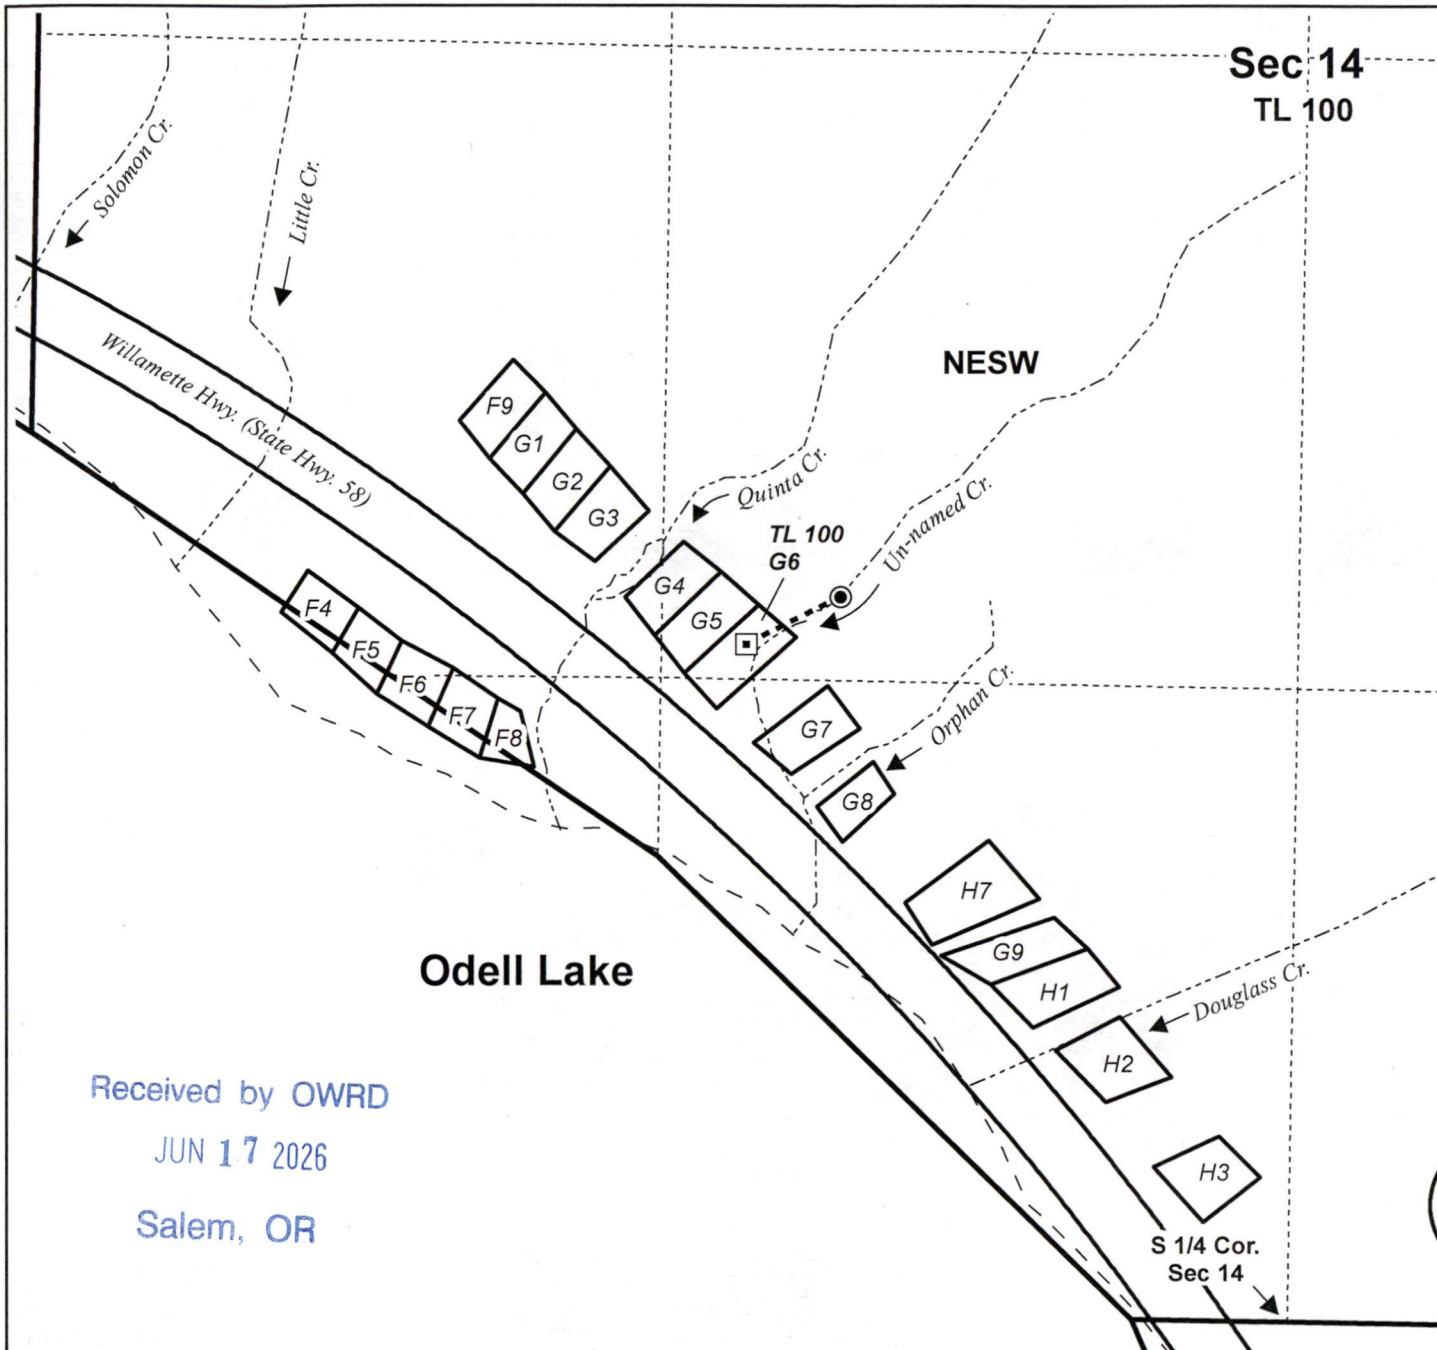

Odell Lake

Received by OWRD

JUN 17 2026

Salem, OR



RENEWS: 06/30/2026

**CLAIM OF BENEFICIAL USE MAP
CORBIN PIERCE / ARLO & SALLY GOODWIN**

Date: 6/17/2026


Ap S-87349 Permit S-54666

This map is not intended
to provide legal dimensions
or locations of property
ownership lines.

WATER RIGHT SERVICES, LLC
PO BOX 1830, BEND, OR 97709
WWW.OREGONWATER.US 541-389-2837
info@oregonwater.us

**T23S R6E, WM
KLAMATH COUNTY, OR**

**Sec 14
TL 100**

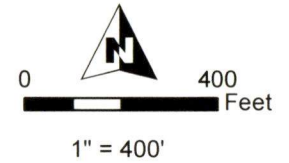

- POD
- Cabin & Meter
- Creek
- - - Edge of Odell Lake
- Pipeline
- Section
- Quarter Quarter
- Tax Lot

POD Location:
1510' N, 930' W of S 1/4 Cor Sec 14

Odell Lake

Superseded



RENEWS: 06/30/2026



**CLAIM OF BENEFICIAL USE MAP
CORBIN PIERCE / ARLO & SALLY GOODWIN**

Date: 11/15/2024

Ap S-87349 Permit S-54666

This map is not intended
to provide legal dimensions
or locations of property
ownership lines.

WATER RIGHT SERVICES, LLC

PO BOX 1830, BEND, OR 97709

WWW.OREGONWATER.US 541-389-2837

johnshort@usa.com

CCB # 197121

Received
JUN 11 2026
OWRD