


CLAIM OF BENEFICIAL USE MAP

TO CHANGE POINT OF APPROPRIATION AND PLACE OF USE
FOR TRANSFER APPLICATION T-14226

SECTION 1, TOWNSHIP 27 SOUTH, RANGE 33 EAST, W.M.
TAX LOT: 200

Received by OWRD
JUN 22 2026

Salem, OR

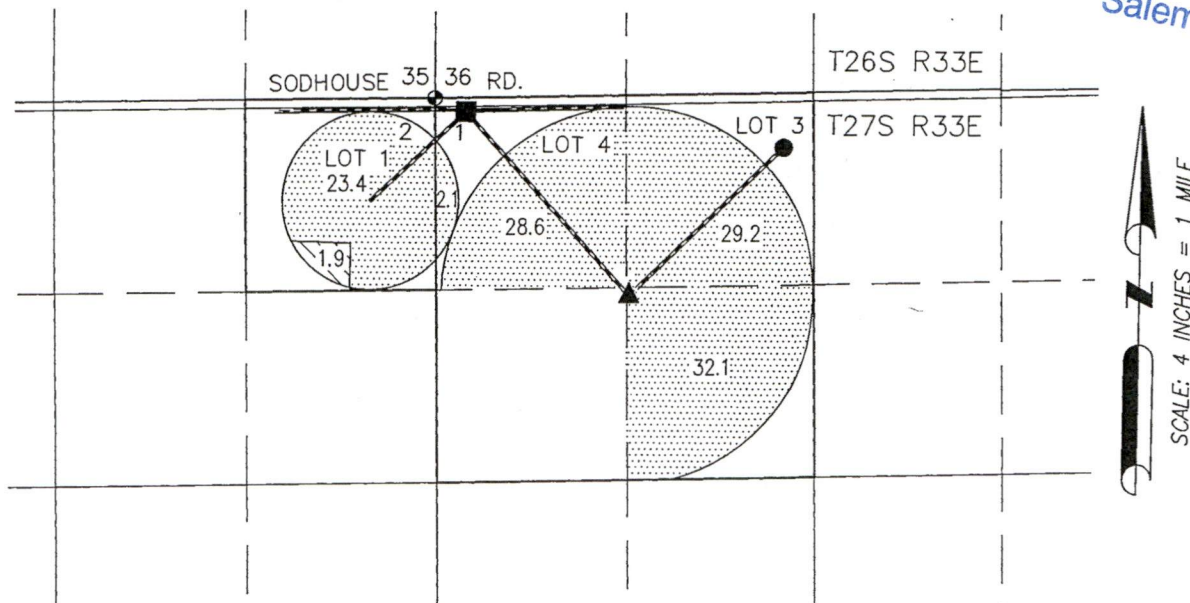


- KREGER #1 43°15'42.51" N & 118°36'05.67" W
(HARN 51541) LOCATED 90 FEET SOUTH AND 235 FEET
EAST FROM THE NW CORNER OF SECTION 1. FLOW
METER IS 5.5' N FROM WELL.
- KREGER #5 43°15'39.50" N & 118°35'35.86" W
(HARN 52418) LOCATED 375 FEET SOUTH AND 2375
FEET EAST FROM THE NW CORNER OF SECTION 1.
FLOW METER IS LOCATED ON Z-PIPE OF CENTER PIVOT
SPRINKLER, AS SHOWN.
- ▲ KREGER #5 FLOW METER LOCATED 1375' S & 1330' E
FROM NW CORNER SECTION 1.

BURIED 6 OR 8 INCH STEEL PIPE

 115.4 ACRES 'IR' FROM CERTIFICATE 95966
(PERMIT G-8527), PER T-14226, AS SHOWN.

 1.9 ACRES 'IR' FROM CERTIFICATE 95966
(PERMIT G-8527), PER T-14226, AS SHOWN.

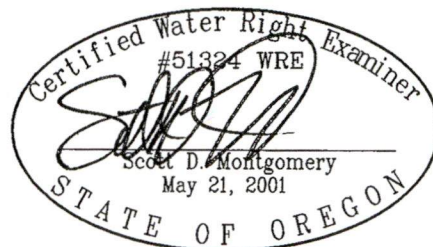

RENEWAL DATE: 12/31/2026

THIS MAP IS FOR THE PURPOSE OF LOCATING A WATER
RIGHT ONLY AND HAS NO INTENT TO PROVIDE LEGAL
DIMENSIONS OR THE LOCATION OF PROPERTY LINES

PREPARED FOR:

JIM AND SUE GILMOUR
30427 STELLMACHER DRIVE
ALBANY, OR 97321

PREPARED BY:




ALL POINTS ENGINEERING AND SURVEYING, INC.
P.O. BOX 767 TERREBONNE, OR 97760
(541) 548-5833
www.APEandS.com

CLAIM OF BENEFICIAL USE MAP

TO CHANGE POINT OF APPROPRIATION AND PLACE OF USE
FOR TRANSFER APPLICATION T-14226

SECTIONS 5 & 6, TOWNSHIP 27 SOUTH, RANGE 34 EAST, W.M.
TAX LOT: 601 & 700

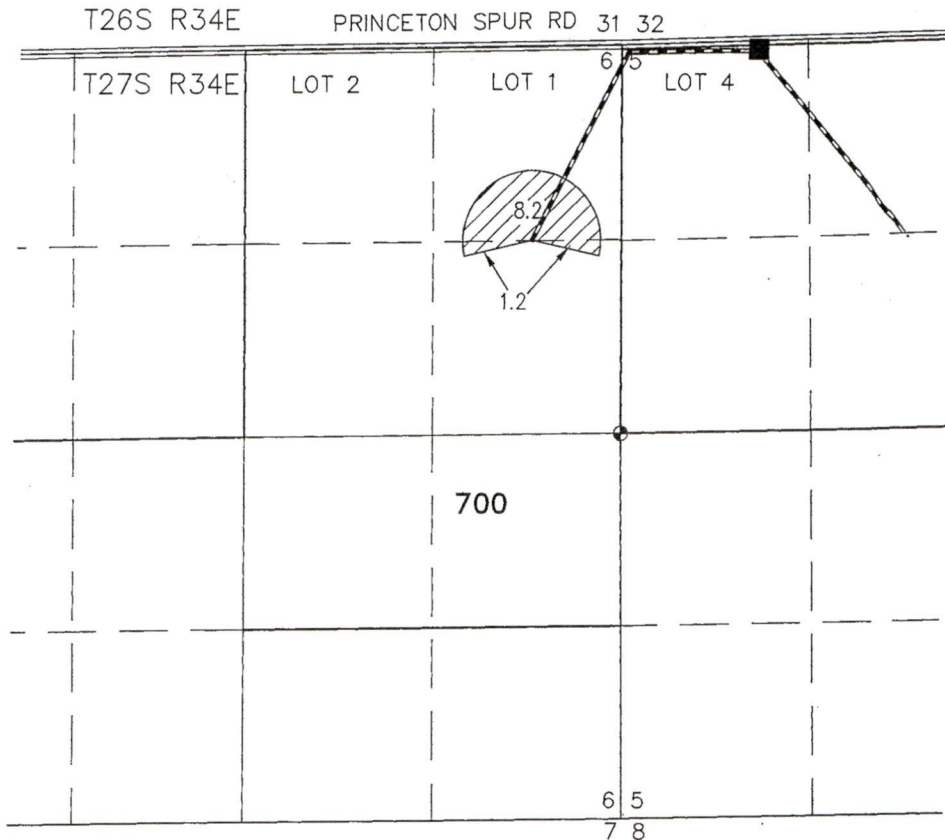


Received by OWRD
JUN 22 2026
Salem, OR


■ BUFFALO WELL 43°15'42.58" N & 118°33'36.58" W
(HARN 50318) LOCATED 35 FEET SOUTH AND 975
FEET EAST FROM THE NW CORNER OF SECTION 5.
FLOW METER IS 6.5 FEET SOUTH FROM WELL.

BURIED 6 OR 8 INCH STEEL PIPE

THIS MAP IS FOR THE PURPOSE OF LOCATING A WATER
RIGHT ONLY AND HAS NO INTENT TO PROVIDE LEGAL
DIMENSIONS OR THE LOCATION OF PROPERTY LINES

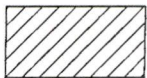

9.4 ACRES 'IR' FROM CERTIFICATE 95966
(PERMIT G-8527), PER T-14226, AS SHOWN.

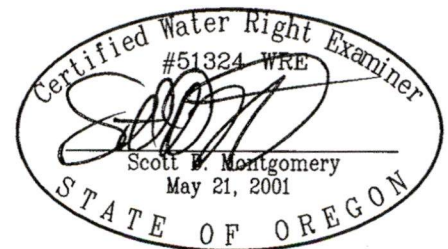

RENEWAL DATE: 12/31/2026

PREPARED FOR:

JIM AND SUE GILMOUR
30427 STELLMACHER DRIVE
ALBANY, OR 97321

PREPARED BY:




ALL POINTS ENGINEERING AND SURVEYING, INC.
P.O. BOX 767 TERREBONNE, OR 97760
(541) 548-5833 www.APEandS.com

CLAIM OF BENEFICIAL USE MAP

TO CHANGE POINT OF APPROPRIATION AND PLACE OF USE
FOR TRANSFER APPLICATION T-14226

SECTION 1, TOWNSHIP 27 SOUTH, RANGE 33 EAST, W.M.
TAX LOT: 200

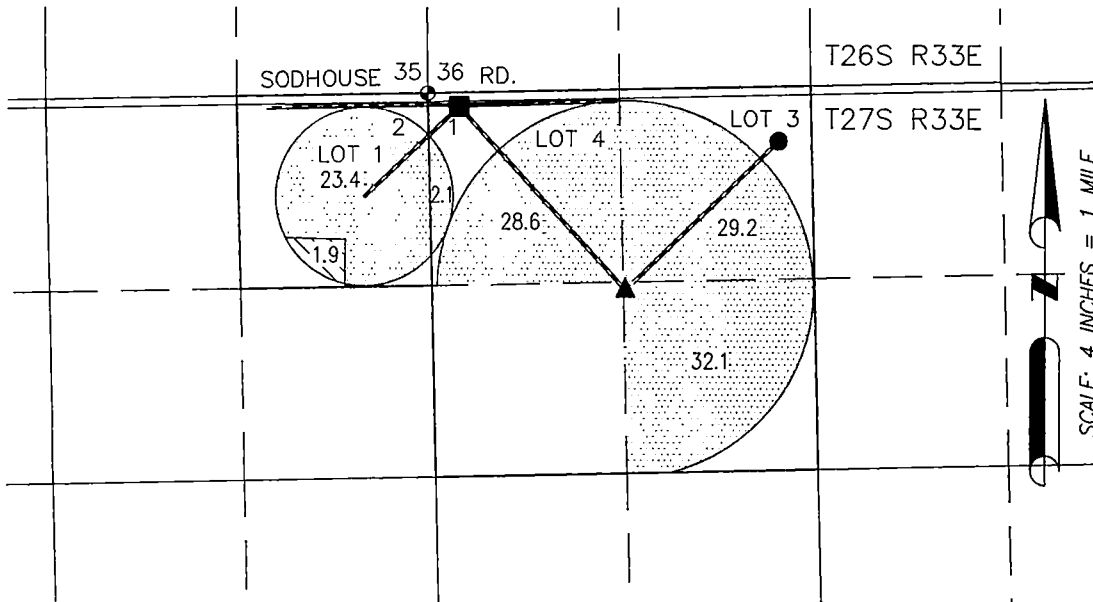

KREGER #1


■ (HARN 51541) LOCATED 90 FEET SOUTH AND 235 FEET EAST FROM THE NW CORNER OF SECTION 1. FLOW METER IS 5.5' N FROM WELL.

KREGER #5

● (HARN 52418) LOCATED 375 FEET SOUTH AND 2375 FEET EAST FROM THE NW CORNER OF SECTION 1. FLOW METER IS LOCATED ON Z-PIPE OF CENTER PIVOT SPRINKLER, AS SHOWN.

▲ KREGER #5 FLOW METER LOCATED 1375' S & 1330' E FROM NW CORNER SECTION 1.

BURIED 6 OR 8 INCH STEEL PIPE

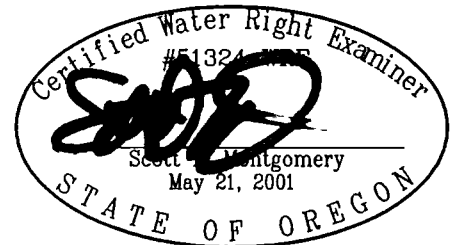

RENEWAL DATE: 12/31/2026

115.4 ACRES 'IR' FROM CERTIFICATE 95966
(PERMIT G-8527), PER T-14226, AS SHOWN.

1.9 ACRES 'IR' FROM CERTIFICATE 95966
(PERMIT G-8527), PER T-14226, AS SHOWN.

THIS MAP IS FOR THE PURPOSE OF LOCATING A WATER
RIGHT ONLY AND HAS NO INTENT TO PROVIDE LEGAL
DIMENSIONS OR THE LOCATION OF PROPERTY LINES

Superseded

PREPARED FOR:

JIM AND SUE GILMOUR
30427 STELLMACHER DRIVE
ALBANY, OR 97321

PREPARED BY:




ALL POINTS ENGINEERING AND SURVEYING, INC.
P.O. BOX 767 TERREBONNE, OR 97760
(541) 548-5833 www.APEandS.com

CLAIM OF BENEFICIAL USE MAP

TO CHANGE POINT OF APPROPRIATION AND PLACE OF USE FOR TRANSFER APPLICATION T-14226

SECTIONS 5 & 6, TOWNSHIP 27 SOUTH, RANGE 34 EAST, W.M.
TAX LOT: 601 & 700

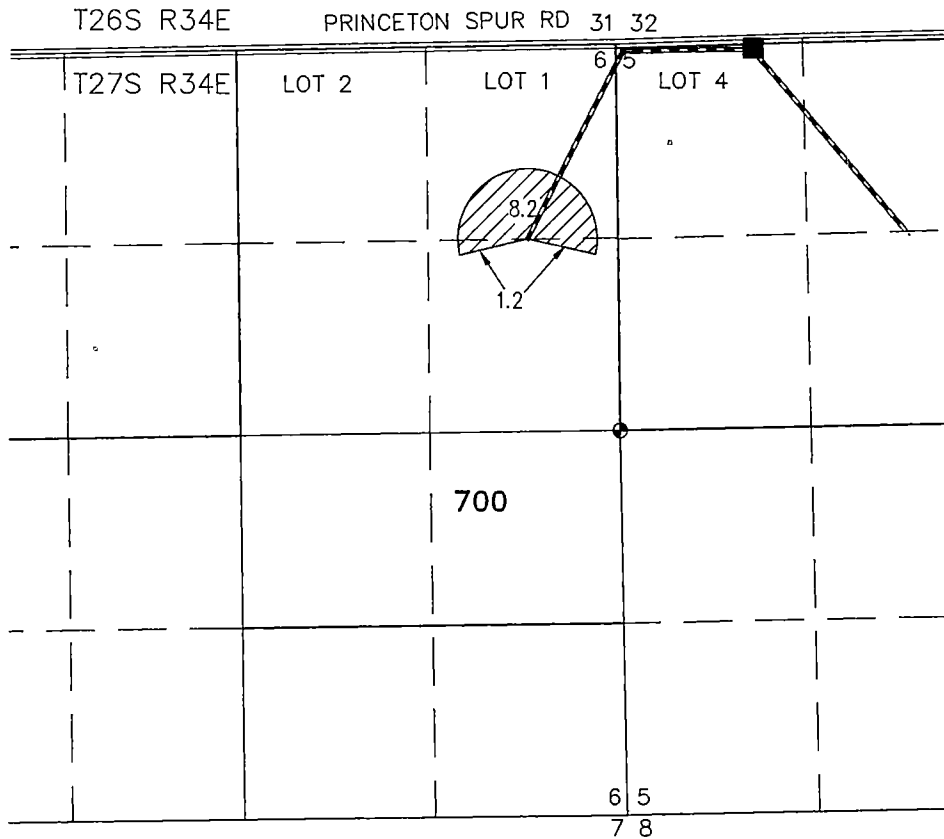


BUFFALO WELL


(HARN 50318) LOCATED 35 FEET SOUTH AND 975 FEET EAST FROM THE NW CORNER OF SECTION 5. FLOW METER IS 6.5 FEET SOUTH FROM WELL.

BURIED 6 OR 8 INCH STEEL PIPE

THIS MAP IS FOR THE PURPOSE OF LOCATING A WATER RIGHT ONLY AND HAS NO INTENT TO PROVIDE LEGAL DIMENSIONS OR THE LOCATION OF PROPERTY LINES

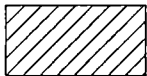

9.4 ACRES 'IR' FROM CERTIFICATE 95966
(PERMIT G-8527), PER T-14226, AS SHOWN.

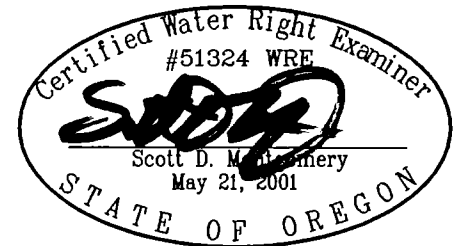

Superseded

RENEWAL DATE: 12/31/2026

PREPARED FOR:

JIM AND SUE GILMOUR
30427 STELLMACHER DRIVE
ALBANY, OR 97321

PREPARED BY:



ALL POINTS ENGINEERING AND SURVEYING, INC.
P.O. BOX 767 TERREBONNE, OR 97760
(541) 548-5833 www.APEandS.com