


CLAIM OF BENEFICIAL USE MAP

TO CHANGE POINT OF APPROPRIATION AND PLACE OF USE
FOR TRANSFER APPLICATION T-14227

SECTIONS 5 & 6, TOWNSHIP 27 SOUTH, RANGE 34 EAST, W.M.
TAX LOT: 601 & 700

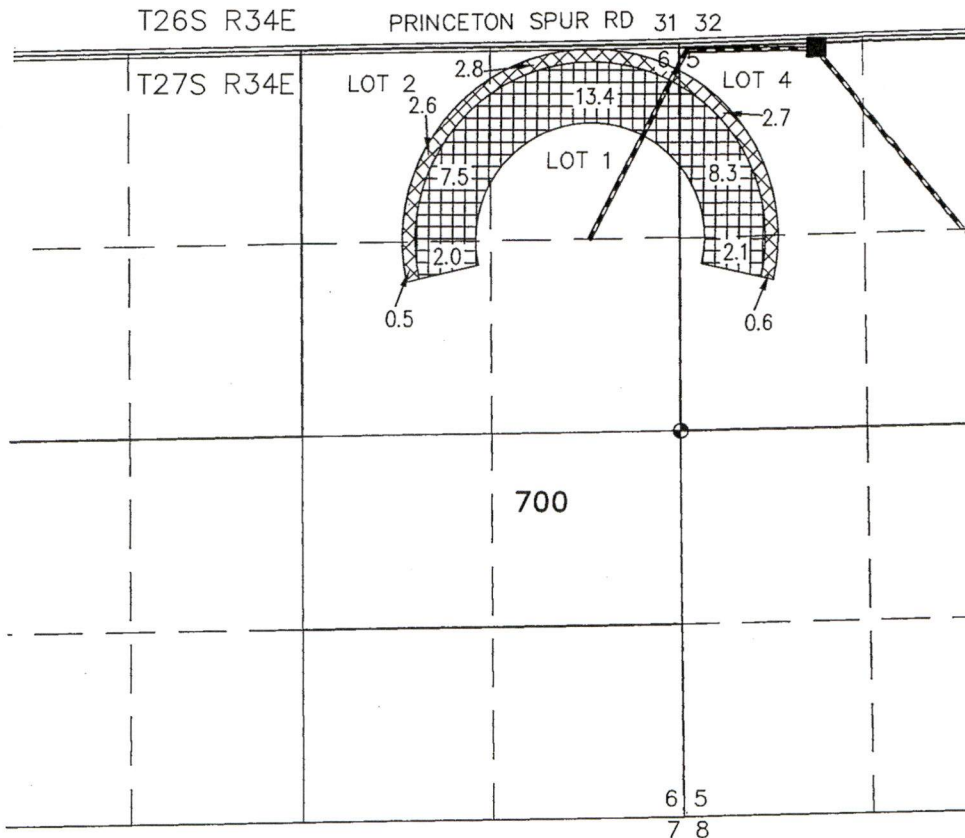


SCALE: 4 INCHES = 1 MILE

Received by OWRD
JUN 22 2026
Salem, OR

BUFFALO WELL 43°15'42.58" N & 118°33'36.58" W
(HARN 50318) LOCATED 35 FEET SOUTH AND 975
FEET EAST FROM THE NW CORNER OF SECTION 5.
FLOW METER IS 6.5 FEET SOUTH FROM WELL.

BURIED 6 OR 8 INCH STEEL PIPE

THIS MAP IS FOR THE PURPOSE OF LOCATING A WATER
RIGHT ONLY AND HAS NO INTENT TO PROVIDE LEGAL
DIMENSIONS OR THE LOCATION OF PROPERTY LINES

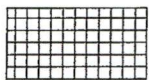


33.3 ACRES 'IR' FROM CERTIFICATE 91034
(PERMIT G-15663), PER T-14227, AS SHOWN.



9.2 ACRES 'IR' FROM CERTIFICATE 96822
(PERMIT G-18086), PER T-14227, AS SHOWN.

Scott D
Montgomery

Digitally signed by Scott D Montgomery
DN: cn=Scott D Montgomery, o=All
Points Engineering and Surveying, Inc.,
ou=email=scott@apeands.com, c=US
Date: 2026.06.22 14:25:48 -0700

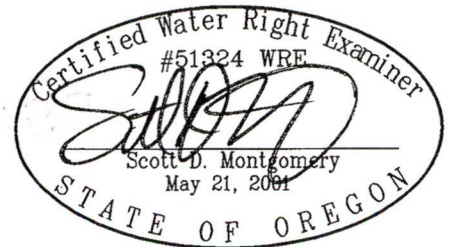

RENEWAL DATE: 12/31/2026

PREPARED FOR:

JIM AND SUE GILMOUR
30427 STELLMACHER DRIVE
ALBANY, OR 97321

PREPARED BY:





ALL POINTS ENGINEERING AND SURVEYING, INC.
P.O. BOX 767 TERREBONNE, OR 97760
(541) 548-5833 www.APEandS.com

CLAIM OF BENEFICIAL USE MAP


TO CHANGE POINT OF APPROPRIATION AND PLACE OF USE FOR TRANSFER APPLICATION T-14227

SECTIONS 5 & 6, TOWNSHIP 27 SOUTH, RANGE 34 EAST, W.M.
TAX LOT: 601 & 700

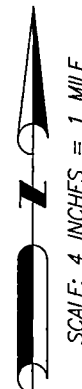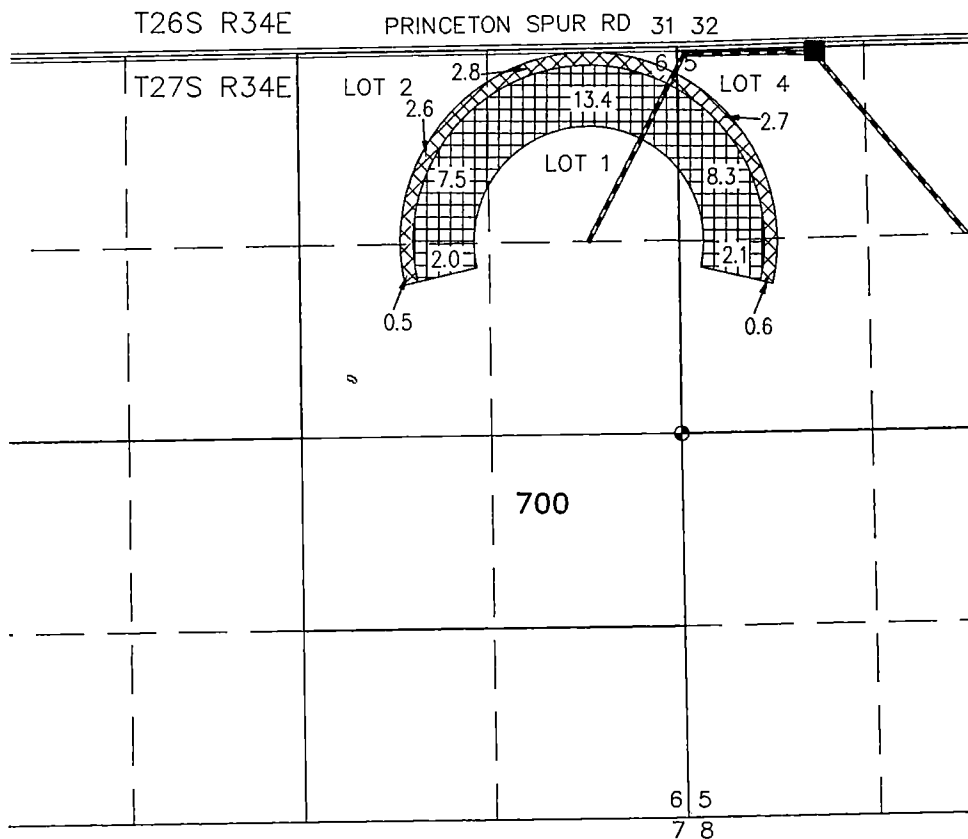

BUFFALO WELL

(HARN 50318) LOCATED 35 FEET SOUTH AND 975 FEET EAST FROM THE NW CORNER OF SECTION 5. FLOW METER IS 6.5 FEET SOUTH FROM WELL.

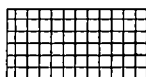


33.3 ACRES 'IR' FROM CERTIFICATE 91034
(PERMIT G-15663), PER T-14227, AS SHOWN.



9.2 ACRES 'IR' FROM CERTIFICATE 96822
(PERMIT G-18086), PER T-14227, AS SHOWN.

BURIED 6 OR 8 INCH STEEL PIPE

THIS MAP IS FOR THE PURPOSE OF LOCATING A WATER RIGHT ONLY AND HAS NO INTENT TO PROVIDE LEGAL DIMENSIONS OR THE LOCATION OF PROPERTY LINES

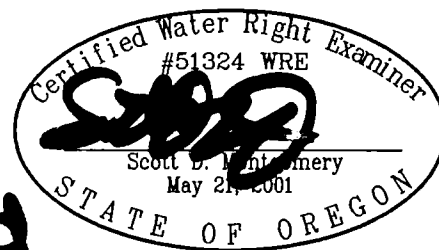

Superseded

RENEWAL DATE: 12/31/2026

PREPARED FOR:

JIM AND SUE GILMOUR
30427 STELLMACHER DRIVE
ALBANY, OR 97321

PREPARED BY:



ALL POINTS ENGINEERING AND SURVEYING, INC.
P.O. BOX 767 TERREBONNE, OR 97760
(541) 548-5833 www.APEandS.com