


CLAIM OF BENEFICIAL USE MAP

TO CHANGE POINT OF APPROPRIATION AND PLACE OF USE
FOR TRANSFER APPLICATION T-14399

SECTIONS 5 & 6, TOWNSHIP 27 SOUTH, RANGE 34 EAST, W.M.
TAX LOT: 601 & 700

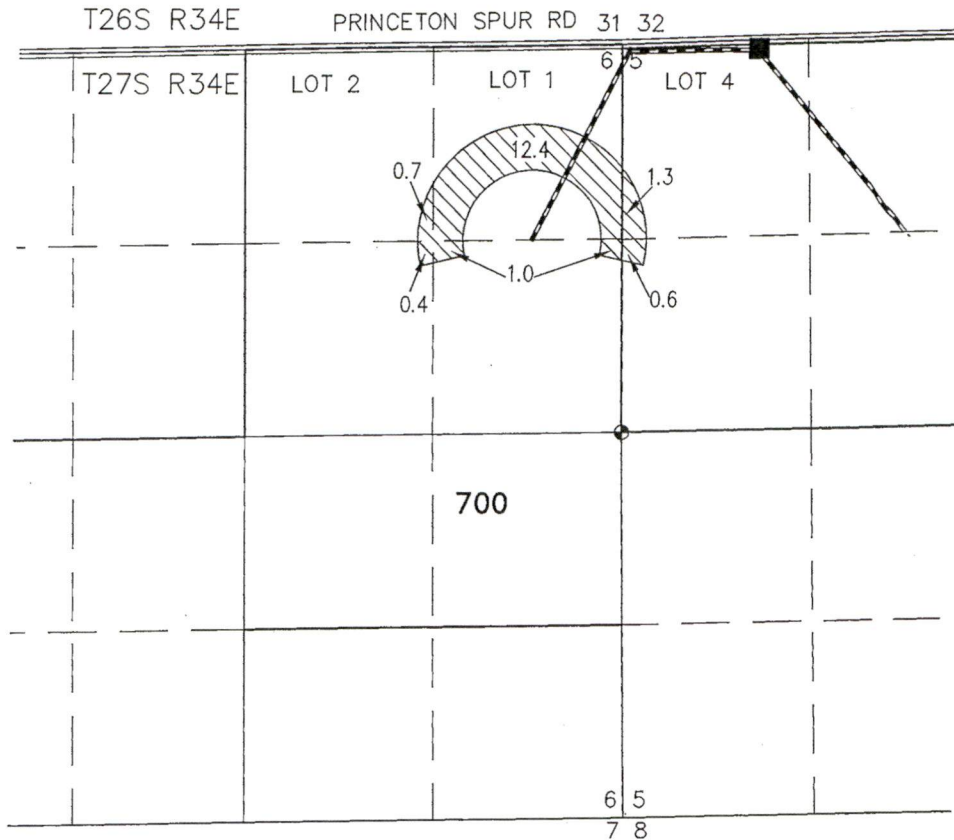

Received by OWRD

JUN 22 2026

Salem, OR


BUFFALO WELL 43°15'42.58" N & 118°33'36.58" W
(HARN 50318) LOCATED 35 FEET SOUTH AND 975
FEET EAST FROM THE NW CORNER OF SECTION 5.
FLOW METER IS 6.5 FEET SOUTH FROM WELL.

BURIED 6 OR 8 INCH STEEL PIPE

THIS MAP IS FOR THE PURPOSE OF LOCATING A WATER
RIGHT ONLY AND HAS NO INTENT TO PROVIDE LEGAL
DIMENSIONS OR THE LOCATION OF PROPERTY LINES



16.4 ACRES 'IR' FROM CERTIFICATE 97231
(PERMIT G-12961), PER T-14399, AS SHOWN.

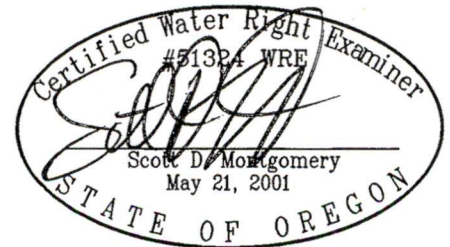

RENEWAL DATE: 12/31/2026

PREPARED FOR:

JIM AND SUE GILMOUR
30427 STELLMACHER DRIVE
ALBANY, OR 97321

PREPARED BY:




ALL POINTS ENGINEERING AND SURVEYING, INC.
P.O. BOX 767 TERREBONNE, OR 97760
(541) 548-5833
www.APEandS.com

CLAIM OF BENEFICIAL USE MAP

TO CHANGE POINT OF APPROPRIATION AND PLACE OF USE
FOR TRANSFER APPLICATION T-14399

SECTIONS 5 & 6, TOWNSHIP 27 SOUTH, RANGE 34 EAST, W.M.
TAX LOT: 601 & 700

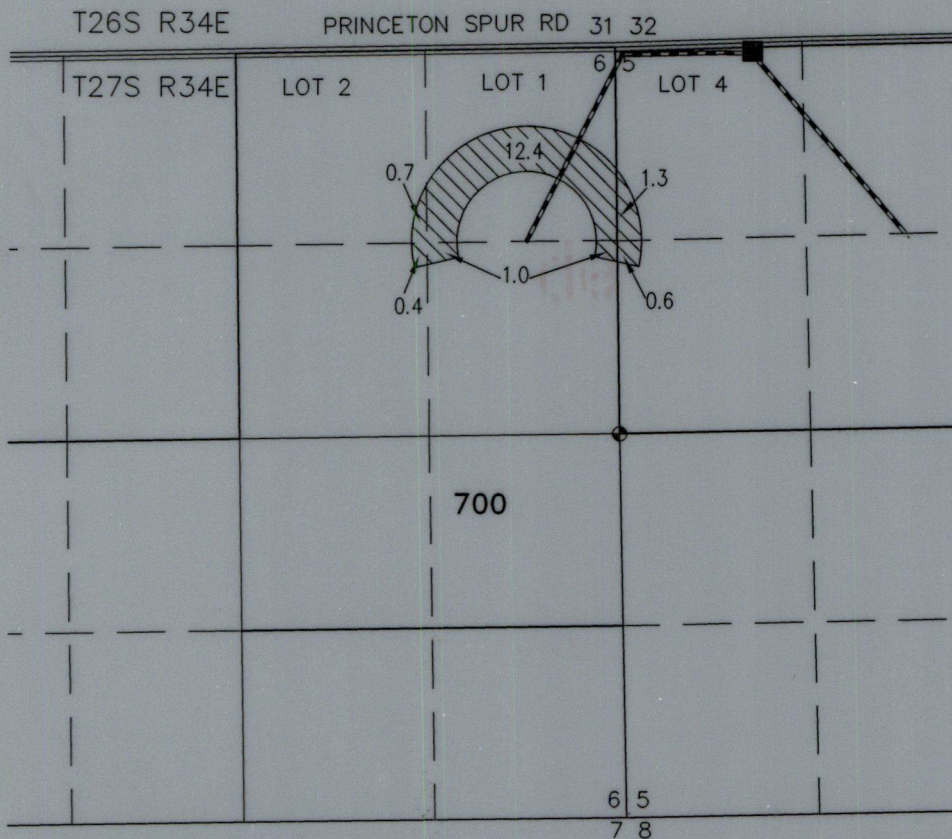

Received
JUN 17 2026
OWRD

BUFFALO WELL

(HARN 50318) LOCATED 35 FEET SOUTH AND 975 FEET EAST FROM THE NW CORNER OF SECTION 5. FLOW METER IS 6.5 FEET SOUTH FROM WELL.




16.4 ACRES 'IR' FROM CERTIFICATE 97231
(PERMIT G-12961), PER T-14399, AS SHOWN.

BURIED 6 OR 8 INCH STEEL PIPE

THIS MAP IS FOR THE PURPOSE OF LOCATING A WATER RIGHT ONLY AND HAS NO INTENT TO PROVIDE LEGAL DIMENSIONS OR THE LOCATION OF PROPERTY LINES

Superseded

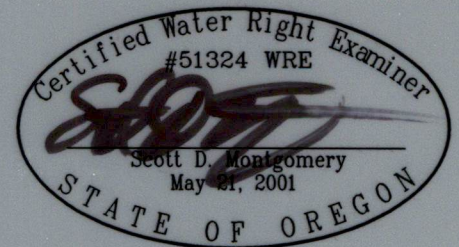

RENEWAL DATE: 12/31/2026

PREPARED FOR:

JIM AND SUE GILMOUR
30427 STELLMACHER DRIVE
ALBANY, OR 97321

PREPARED BY:



ALL POINTS ENGINEERING AND SURVEYING, INC.
P.O. BOX 767 TERREBONNE, OR 97760
(541) 548-5833 www.APEandS.com